

Exp ASAP

~~DEFINITION~~
~~ISSUE~~

Work Order ID 96332

96332

Page 1

January-24-13 8:44:08 AM

Item ID: D3315-1

Accept

N900040100

Setup Start *NS1*

Revision ID: U/R

Stop *NS2*

Item Name: Wearplate

Start Date: 1/31/13 Start Qty: 24.00

24
*24*21

Cust Item ID:

Required Date: 1/31/13 Req'd Qty: 24.00

Customer:

Reference:

Approvals: Process Plan: U Date: _____ Tooling: _____ Date: _____
QC: _____ Date: _____ SPC (Y/N): _____ Date: _____

Run Start *NR1*

Stop *NR2*

| Sequence ID/ Work Center ID | Operation Description | Set Up/ Run Hours | Tool ID | Tool # | Plan Code | Accept Qty | Reject Qty | Reject Number | Insp. Stamp |
|--------------------------------|--------------------------|----------------------|---------|--------|--------------|---------------|---------------|------------------|----------------|
|--------------------------------|--------------------------|----------------------|---------|--------|--------------|---------------|---------------|------------------|----------------|

| Draw Nbr | Revision Nbr |
|----------|--------------|
| D3315 | pc2 |

| | | |
|-----|--|------|
| 100 | | 0.00 |
|-----|--|------|

100

Waterjet

FLOW CNC Waterjet

FLOW WATER JET

Memo

1-Cut as per Dwg D3315

Dwg Rev: PC2

Prog Rev: PC2

2-Deburr if necessary

0.00

21 0 Jm B-1-24

| | | |
|-----|--|------|
| 110 | | 0.00 |
|-----|--|------|

110

QC

Quality Control

QC2- Inspect parts off machine FAI/FAIB

Memo

0.00

24 0 Jm B-1-24

| | | |
|-----|--|------|
| 120 | | 0.00 |
|-----|--|------|

120

QC

Quality Control

QC8- Inspect parts - second check

Memo

0.00

inspect to PC2

Dwg only

DAS
16
2-23

with
(PC2)

NCR: Yes / No

WORK ORDER NON-CONFORMANCE / UPDATE

DQA: _____ Date: _____

QA Closed: _____ Date: _____

| | | | | | | | | | | | | | | | | | | |
|--|---|---|--------------------------------------|------------------------------------|------------------------------------|--------------------------------------|------------------------------------|------------------------------------|--|----------------------------------|--|------------------------------------|--|--------------------------------|------------------------------------|------------------------------------|-----------------------------------|--|
| Work Order: _____ Part No. _____ NCR No. _____ | DISPOSITION Rework <input type="checkbox"/> Scrap <input type="checkbox"/> Use-as-is <input type="checkbox"/> Work Order Update <input type="checkbox"/> | AGAINST DEPARTMENT/PROCESS <table style="width: 100%;"> <tr> <td>Skid-tube <input type="checkbox"/></td> <td>Crosstube <input type="checkbox"/></td> <td>Water Jet <input type="checkbox"/></td> <td>Engineering <input type="checkbox"/></td> </tr> <tr> <td>Machining <input type="checkbox"/></td> <td>Small Fab <input type="checkbox"/></td> <td>Prod. Eng. Coord. <input type="checkbox"/></td> <td>Quality <input type="checkbox"/></td> </tr> <tr> <td>Thermoforming <input type="checkbox"/></td> <td>Finishing <input type="checkbox"/></td> <td>Rec/Store/Packaging <input type="checkbox"/></td> <td>Other <input type="checkbox"/></td> </tr> <tr> <td>Large Fab <input type="checkbox"/></td> <td>Composite <input type="checkbox"/></td> <td>Supplier <input type="checkbox"/></td> <td></td> </tr> </table> | Skid-tube <input type="checkbox"/> | Crosstube <input type="checkbox"/> | Water Jet <input type="checkbox"/> | Engineering <input type="checkbox"/> | Machining <input type="checkbox"/> | Small Fab <input type="checkbox"/> | Prod. Eng. Coord. <input type="checkbox"/> | Quality <input type="checkbox"/> | Thermoforming <input type="checkbox"/> | Finishing <input type="checkbox"/> | Rec/Store/Packaging <input type="checkbox"/> | Other <input type="checkbox"/> | Large Fab <input type="checkbox"/> | Composite <input type="checkbox"/> | Supplier <input type="checkbox"/> | |
| Skid-tube <input type="checkbox"/> | Crosstube <input type="checkbox"/> | Water Jet <input type="checkbox"/> | Engineering <input type="checkbox"/> | | | | | | | | | | | | | | | |
| Machining <input type="checkbox"/> | Small Fab <input type="checkbox"/> | Prod. Eng. Coord. <input type="checkbox"/> | Quality <input type="checkbox"/> | | | | | | | | | | | | | | | |
| Thermoforming <input type="checkbox"/> | Finishing <input type="checkbox"/> | Rec/Store/Packaging <input type="checkbox"/> | Other <input type="checkbox"/> | | | | | | | | | | | | | | | |
| Large Fab <input type="checkbox"/> | Composite <input type="checkbox"/> | Supplier <input type="checkbox"/> | | | | | | | | | | | | | | | | |

| Root Cause | Date | Step | Qty | Description of work order update or Non-conformance | Initial Chief Eng | Action Description | Sign & Date | Verification | QC Inspector |
|---------------|------|------|-----|---|-------------------|--------------------|-------------|--------------|--------------|
| Doc/Data | | | | | | | | | |
| Equip/Tooling | | | | | | | | | |
| Operator | | | | | | | | | |
| Material | | | | | | | | | |
| Setup | | | | | | | | | |
| Other | | | | | | | | | |
| Process | | | | | | | | | |
| Supplier | | | | | | | | | |
| Training | | | | | | | | | |
| Unapproved | | | | | | | | | |

FAULT CATEGORY

| | | |
|--|---|---|
| Landing Gear <input type="checkbox"/> Bending <input type="checkbox"/> Centre Not Concentric to O/S <input type="checkbox"/> Cracks <input type="checkbox"/> Crushed/Crimped. <input type="checkbox"/> Cuffs <input type="checkbox"/> Heat Treat <input type="checkbox"/> Inspection Strip in Tube <input type="checkbox"/> Ripples in Bend <input type="checkbox"/> Torque Waves in Extrusion <input type="checkbox"/> Turning Sequence <input type="checkbox"/> Wave/Twist in Tube | General <input type="checkbox"/> Bend <input type="checkbox"/> BOM/Route <input type="checkbox"/> Broken/Damaged <input type="checkbox"/> Burrs <input type="checkbox"/> Contamination <input type="checkbox"/> Countersink <input type="checkbox"/> Cut Too Short <input type="checkbox"/> Drill Holes <input type="checkbox"/> Drawing <input type="checkbox"/> Finish <input type="checkbox"/> Folio | <input type="checkbox"/> Grain <input type="checkbox"/> Hardware <input type="checkbox"/> Inspection Incomplete <input type="checkbox"/> Instructions Incomplete/Unclear <input type="checkbox"/> Maintenance <input type="checkbox"/> Mislabeled <input type="checkbox"/> Misread <input type="checkbox"/> Offset <input type="checkbox"/> Out of Calibration <input type="checkbox"/> Out of Sequence <input type="checkbox"/> Outside Dimensions |
| | | <input type="checkbox"/> Ovalized <input type="checkbox"/> Over/Under tolerance <input type="checkbox"/> Part Incorrect <input type="checkbox"/> Part Lost/Missing <input type="checkbox"/> Part Moved <input type="checkbox"/> Positioned Wrong <input type="checkbox"/> Power Loss/Surge |
| | | <input type="checkbox"/> Pressure/Forced <input type="checkbox"/> Temperature/Cure <input type="checkbox"/> Weld <input type="checkbox"/> Wrong Stock Pulled <input type="checkbox"/> Other |

Work Order ID 96332

January-24-13 8:44:08 AM

96332

Page 2

Item ID: D3315-1 Accept ***N900040100*** Setup Start ***NS1***
Revision ID: U/R Stop ***NS2***
Item Name: Wearplate
Start Date: 1/31/13 Start Qty: 24.00 ***24*** Cust Item ID:
Required Date: 1/31/13 Req'd Qty: 24.00 ***24*** Customer:
Reference:

Approvals: Process Plan: _____ Date: _____ Tooling: _____ Date: _____ Run Start ***NR1***
QC: _____ Date: _____ SPC (Y/N): _____ Date: _____ Stop ***NR2***

| Sequence ID/ Work Center ID | Operation Description | Set Up/ Run Hours | Tool ID | Tool # | Plan Code | Accept Qty | Reject Qty | Reject Number | Insp. Stamp |
|--------------------------------|--|----------------------|---------|--------|--------------|---------------|---------------|------------------|----------------|
| 130 | | 0.00 | | | | | | | |
| *130* | Small Fab | | | | | | | | |
| Small Fab | Memo | 0.00 | | | | | | | |
| Small Fab | Deburr if necessary | | | | | | | | |
| 140 | | 0.00 | | | | | | | |
| *140* | NC BRAKE | | | | | | | | |
| Brake NC | Memo | 0.00 | | | | | | | |
| Brake NC | 1- Form using DT8751 Die as per Dwg D3315 | | | | | | | | |
| | Rev: <u>PC 2</u> | | | | | | | | |
| | 2- Form using DT8179 Die and form joggle using DT8157 as per Dwg D3315 | | | | | | | | |
| | Rev: <u>PC 2</u> | | | | | | | | |
| 150 | | 0.00 | | | | | | | |
| *150* | QC6- Inspect dimensions to drawing | | | | | | | | |
| QC | Memo | 0.00 | | | | | | | |
| Quality Control | | | | | | | | | |

DAS
16
2-88

131125

NCR: Yes / No

WORK ORDER NON-CONFORMANCE / UPDATE

DQA: _____ Date: _____

QA Closed: _____ Date: _____

| | | | | | | | | | | | |
|--|------|------|-----|---|-------------------|---|-------------|--------------|--------------|--|--|
| Work Order: _____ Part No. _____ NCR No. _____ | | | | DISPOSITION Rework <input type="checkbox"/> Scrap <input type="checkbox"/> Use-as-is <input type="checkbox"/> Work Order Update <input type="checkbox"/> | | AGAINST DEPARTMENT/PROCESS <div style="display: flex; justify-content: space-between;"> <div> Skid-tube <input type="checkbox"/> Machining <input type="checkbox"/> Thermoforming <input type="checkbox"/> Large Fab <input type="checkbox"/> </div> <div> Crosstube <input type="checkbox"/> Small Fab <input type="checkbox"/> Finishing <input type="checkbox"/> Composite <input type="checkbox"/> </div> <div> Water Jet <input type="checkbox"/> Prod. Eng. Coord. <input type="checkbox"/> Rec/Store/Packaging <input type="checkbox"/> Supplier <input type="checkbox"/> </div> <div> Engineering <input type="checkbox"/> Quality <input type="checkbox"/> Other <input type="checkbox"/> </div> </div> | | | | | |
| Root Cause | Date | Step | Qty | Description of work order update or Non-conformance | Initial Chief Eng | Action Description | Sign & Date | Verification | QC Inspector | | |
| Doc/Data <input type="checkbox"/> | | | | | | | | | | | |
| Equip/Tooling <input type="checkbox"/> | | | | | | | | | | | |
| Operator <input type="checkbox"/> | | | | | | | | | | | |
| Material <input type="checkbox"/> | | | | | | | | | | | |
| Setup <input type="checkbox"/> | | | | | | | | | | | |
| Other <input type="checkbox"/> | | | | | | | | | | | |
| Process <input type="checkbox"/> | | | | | | | | | | | |
| Supplier <input type="checkbox"/> | | | | | | | | | | | |
| Training <input type="checkbox"/> | | | | | | | | | | | |
| Unapproved <input type="checkbox"/> | | | | | | | | | | | |

| FAULT CATEGORY | | | |
|--|---|---|---|
| Landing Gear <input type="checkbox"/> Bending <input type="checkbox"/> Centre Not Concentric to O/S <input type="checkbox"/> Cracks <input type="checkbox"/> Crushed/Crimped. <input type="checkbox"/> Cuffs <input type="checkbox"/> Heat Treat <input type="checkbox"/> Inspection Strip in Tube <input type="checkbox"/> Ripples in Bend <input type="checkbox"/> Torque Waves in Extrusion <input type="checkbox"/> Turning Sequence <input type="checkbox"/> Wave/Twist in Tube | General <input type="checkbox"/> Bend <input type="checkbox"/> BOM/Route <input type="checkbox"/> Broken/Damaged <input type="checkbox"/> Burrs <input type="checkbox"/> Contamination <input type="checkbox"/> Countersink <input type="checkbox"/> Cut Too Short <input type="checkbox"/> Drill Holes <input type="checkbox"/> Drawing <input type="checkbox"/> Finish <input type="checkbox"/> Folio | <input type="checkbox"/> Grain <input type="checkbox"/> Hardware <input type="checkbox"/> Inspection Incomplete <input type="checkbox"/> Instructions Incomplete/Unclear <input type="checkbox"/> Maintenance <input type="checkbox"/> Mislabeled <input type="checkbox"/> Misread <input type="checkbox"/> Offset <input type="checkbox"/> Out of Calibration <input type="checkbox"/> Out of Sequence <input type="checkbox"/> Outside Dimensions | <input type="checkbox"/> Ovalized <input type="checkbox"/> Over/Under tolerance <input type="checkbox"/> Part Incorrect <input type="checkbox"/> Part Lost/Missing <input type="checkbox"/> Part Moved <input type="checkbox"/> Positioned Wrong <input type="checkbox"/> Power Loss/Surge <input type="checkbox"/> Pressure/Forced <input type="checkbox"/> Temperature/Cure <input type="checkbox"/> Weld <input type="checkbox"/> Wrong Stock Pulled <input type="checkbox"/> Other |

Work Order ID 96332

January-24-13 8:44:08 AM

96332

Page 3

Item ID: D3315-1

Accept

N900040100

Setup Start ***NS1***

Revision ID: U/R

Stop ***NS2***

Item Name: Wearplate

Start Date: 1/31/13 Start Qty: 24.00

24

Cust Item ID:

Required Date: 1/31/13 Req'd Qty: 24.00

24

Customer:

Reference:

Approvals: Process Plan: _____ Date: _____ Tooling: _____ Date: _____

Run Start ***NR1***

QC: _____ Date: _____ SPC (Y/N): _____ Date: _____

Stop ***NR2***

| Sequence ID/ Work Center ID | Operation Description | Set Up/ Run Hours | Tool ID | Tool # | Plan Code | Accept Qty | Reject Qty | Reject Number | Insp. Stamp |
|--------------------------------|---|--|---------|--------|--------------|---------------|---------------|------------------|----------------|
| 160 | | 0.00 | | | | | | | |
| *160* | Large Fab | | | | | | | | |
| Large Fab | Memo | 0.00 | | | | | | | |
| Large Fab | Weld hard surface using D3315-IT3 as per QSI 004 and Dwg D3315 Rev: <u>PC2</u> | | | | | | | | |
| | 7560 Hardcoat Rod | <u>123072</u> → 228 <u>124214</u> → 228 | | | | | | | |
| 170 | QC10- Inspect visual per QSI004- ground welds | 0.00 | | | | | | | |
| *170* | | | | | | | | | |
| QC | Memo | 0.00 | | | | | | | |
| Quality Control | | | | | | | | | |
| 180 | QC5- Inspect part completeness to step on W/O | 0.00 | | | | | | | |
| *180* | | | | | | | | | |
| QC | Memo | 0.00 | | | | | | | |
| Quality Control | | | | | | | | | |

(x21) mc 13-01-29

(21) 13-01-29 DAJ
09
2-89

AS
5
89

13-1-30

21

NCR: Yes / No

WORK ORDER NON-CONFORMANCE / UPDATE

DQA: _____ Date: _____

QA Closed: _____ Date: _____

| | | | | | | | | | | | | | | | | | | |
|--|---|---|--------------------------------------|------------------------------------|------------------------------------|--------------------------------------|------------------------------------|------------------------------------|--|----------------------------------|--|------------------------------------|--|--------------------------------|------------------------------------|------------------------------------|-----------------------------------|--|
| Work Order: _____ Part No. _____ NCR No. _____ | DISPOSITION Rework <input type="checkbox"/> Scrap <input type="checkbox"/> Use-as-is <input type="checkbox"/> Work Order Update <input type="checkbox"/> | AGAINST DEPARTMENT/PROCESS <table style="width: 100%;"> <tr> <td>Skid-tube <input type="checkbox"/></td> <td>Crosstube <input type="checkbox"/></td> <td>Water Jet <input type="checkbox"/></td> <td>Engineering <input type="checkbox"/></td> </tr> <tr> <td>Machining <input type="checkbox"/></td> <td>Small Fab <input type="checkbox"/></td> <td>Prod. Eng. Coord. <input type="checkbox"/></td> <td>Quality <input type="checkbox"/></td> </tr> <tr> <td>Thermoforming <input type="checkbox"/></td> <td>Finishing <input type="checkbox"/></td> <td>Rec/Store/Packaging <input type="checkbox"/></td> <td>Other <input type="checkbox"/></td> </tr> <tr> <td>Large Fab <input type="checkbox"/></td> <td>Composite <input type="checkbox"/></td> <td>Supplier <input type="checkbox"/></td> <td></td> </tr> </table> | Skid-tube <input type="checkbox"/> | Crosstube <input type="checkbox"/> | Water Jet <input type="checkbox"/> | Engineering <input type="checkbox"/> | Machining <input type="checkbox"/> | Small Fab <input type="checkbox"/> | Prod. Eng. Coord. <input type="checkbox"/> | Quality <input type="checkbox"/> | Thermoforming <input type="checkbox"/> | Finishing <input type="checkbox"/> | Rec/Store/Packaging <input type="checkbox"/> | Other <input type="checkbox"/> | Large Fab <input type="checkbox"/> | Composite <input type="checkbox"/> | Supplier <input type="checkbox"/> | |
| Skid-tube <input type="checkbox"/> | Crosstube <input type="checkbox"/> | Water Jet <input type="checkbox"/> | Engineering <input type="checkbox"/> | | | | | | | | | | | | | | | |
| Machining <input type="checkbox"/> | Small Fab <input type="checkbox"/> | Prod. Eng. Coord. <input type="checkbox"/> | Quality <input type="checkbox"/> | | | | | | | | | | | | | | | |
| Thermoforming <input type="checkbox"/> | Finishing <input type="checkbox"/> | Rec/Store/Packaging <input type="checkbox"/> | Other <input type="checkbox"/> | | | | | | | | | | | | | | | |
| Large Fab <input type="checkbox"/> | Composite <input type="checkbox"/> | Supplier <input type="checkbox"/> | | | | | | | | | | | | | | | | |

| Root Cause | Date | Step | Qty | Description of work order update or Non-conformance | Initial Chief Eng | Action Description | Sign & Date | Verification | QC Inspector |
|--|------|------|-----|---|-------------------|--------------------|-------------|--------------|--------------|
| Doc/Data <input type="checkbox"/> | | | | | | | | | |
| Equip/Tooling <input type="checkbox"/> | | | | | | | | | |
| Operator <input type="checkbox"/> | | | | | | | | | |
| Material <input type="checkbox"/> | | | | | | | | | |
| Setup <input type="checkbox"/> | | | | | | | | | |
| Other <input type="checkbox"/> | | | | | | | | | |
| Process <input type="checkbox"/> | | | | | | | | | |
| Supplier <input type="checkbox"/> | | | | | | | | | |
| Training <input type="checkbox"/> | | | | | | | | | |
| Unapproved <input type="checkbox"/> | | | | | | | | | |

FAULT CATEGORY

| | | |
|--|---|---|
| Landing Gear <input type="checkbox"/> Bending <input type="checkbox"/> Centre Not Concentric to O/S <input type="checkbox"/> Cracks <input type="checkbox"/> Crushed/Crimped. <input type="checkbox"/> Cuffs <input type="checkbox"/> Heat Treat <input type="checkbox"/> Inspection Strip in Tube <input type="checkbox"/> Ripples in Bend <input type="checkbox"/> Torque Waves in Extrusion <input type="checkbox"/> Turning Sequence <input type="checkbox"/> Wave/Twist in Tube | General <input type="checkbox"/> Bend <input type="checkbox"/> BOM/Route <input type="checkbox"/> Broken/Damaged <input type="checkbox"/> Burrs <input type="checkbox"/> Contamination <input type="checkbox"/> Countersink <input type="checkbox"/> Cut Too Short <input type="checkbox"/> Drill Holes <input type="checkbox"/> Drawing <input type="checkbox"/> Finish <input type="checkbox"/> Folio | <input type="checkbox"/> Grain <input type="checkbox"/> Hardware <input type="checkbox"/> Inspection Incomplete <input type="checkbox"/> Instructions Incomplete/Unclear <input type="checkbox"/> Maintenance <input type="checkbox"/> Mislabeled <input type="checkbox"/> Misread <input type="checkbox"/> Offset <input type="checkbox"/> Out of Calibration <input type="checkbox"/> Out of Sequence <input type="checkbox"/> Outside Dimensions |
| | | <input type="checkbox"/> Ovalized <input type="checkbox"/> Over/Under tolerance <input type="checkbox"/> Part Incorrect <input type="checkbox"/> Part Lost/Missing <input type="checkbox"/> Part Moved <input type="checkbox"/> Positioned Wrong <input type="checkbox"/> Power Loss/Surge |
| | | <input type="checkbox"/> Pressure/Forced <input type="checkbox"/> Temperature/Cure <input type="checkbox"/> Weld <input type="checkbox"/> Wrong Stock Pulled <input type="checkbox"/> Other |

Work Order ID 96332

96332

Page 4

January-24-13 8:44:08 AM

Item ID: D3315-1 Accept *N900040100* Setup Start *NS1*
 Revision ID: U/R Stop *NS2*
 Item Name: Wearplate
 Start Date: 1/31/13 Start Qty: 24.00 *24* Cust Item ID:
 Required Date: 1/31/13 Req'd Qty: 24.00 *24* Customer:
 Reference:

Approvals: Process Plan: _____ Date: _____ Tooling: _____ Date: _____ Run Start *NR1*
 QC: _____ Date: _____ SPC (Y/N): _____ Date: _____ Stop *NR2*

| Sequence ID/ Work Center ID | Operation Description | Set Up/ Run Hours | Tool ID | Tool # | Plan Code | Accept Qty | Reject Qty | Reject Number | Insp. Stamp |
|--|---|----------------------|---------|--------|--------------|---------------|---------------|------------------|----------------|
| 190 *190* Powdercoat Powder Coating | Grey Sandtex(Ref:4.3.5.6) per OSI005 4.3 Memo START TIME: 150 OVEN TEMPERATURE: 330 FINISH TIME: 2100 | 0.00 0.00 | | | | 21 | φ | 131-30 | |
| 200 *200* QC Quality Control | QC3- Inspect Part Finish Memo | 0.00 0.00 | | | | 21 | | | |
| 210 *210* Packaging Packaging | Identify as per dwg & Stock Location: _____ Packaging Memo stow 20XPPP 94917 94916 | 0.00 0.00 | | | | | | | |

1/31/13 (21)

NCR: Yes / No

WORK ORDER NON-CONFORMANCE / UPDATE

DQA: _____ Date: _____

QA Closed: _____ Date: _____

| | | | | | | | | | | | | | | | | | | |
|--|---|---|--------------------------------------|------------------------------------|------------------------------------|--------------------------------------|------------------------------------|------------------------------------|--|----------------------------------|--|------------------------------------|--|--------------------------------|------------------------------------|------------------------------------|-----------------------------------|--|
| Work Order: _____ Part No. _____ NCR No. _____ | DISPOSITION Rework <input type="checkbox"/> Scrap <input type="checkbox"/> Use-as-is <input type="checkbox"/> Work Order Update <input type="checkbox"/> | AGAINST DEPARTMENT/PROCESS <table style="width: 100%;"> <tr> <td>Skid-tube <input type="checkbox"/></td> <td>Crosstube <input type="checkbox"/></td> <td>Water Jet <input type="checkbox"/></td> <td>Engineering <input type="checkbox"/></td> </tr> <tr> <td>Machining <input type="checkbox"/></td> <td>Small Fab <input type="checkbox"/></td> <td>Prod. Eng. Coord. <input type="checkbox"/></td> <td>Quality <input type="checkbox"/></td> </tr> <tr> <td>Thermoforming <input type="checkbox"/></td> <td>Finishing <input type="checkbox"/></td> <td>Rec/Store/Packaging <input type="checkbox"/></td> <td>Other <input type="checkbox"/></td> </tr> <tr> <td>Large Fab <input type="checkbox"/></td> <td>Composite <input type="checkbox"/></td> <td>Supplier <input type="checkbox"/></td> <td></td> </tr> </table> | Skid-tube <input type="checkbox"/> | Crosstube <input type="checkbox"/> | Water Jet <input type="checkbox"/> | Engineering <input type="checkbox"/> | Machining <input type="checkbox"/> | Small Fab <input type="checkbox"/> | Prod. Eng. Coord. <input type="checkbox"/> | Quality <input type="checkbox"/> | Thermoforming <input type="checkbox"/> | Finishing <input type="checkbox"/> | Rec/Store/Packaging <input type="checkbox"/> | Other <input type="checkbox"/> | Large Fab <input type="checkbox"/> | Composite <input type="checkbox"/> | Supplier <input type="checkbox"/> | |
| Skid-tube <input type="checkbox"/> | Crosstube <input type="checkbox"/> | Water Jet <input type="checkbox"/> | Engineering <input type="checkbox"/> | | | | | | | | | | | | | | | |
| Machining <input type="checkbox"/> | Small Fab <input type="checkbox"/> | Prod. Eng. Coord. <input type="checkbox"/> | Quality <input type="checkbox"/> | | | | | | | | | | | | | | | |
| Thermoforming <input type="checkbox"/> | Finishing <input type="checkbox"/> | Rec/Store/Packaging <input type="checkbox"/> | Other <input type="checkbox"/> | | | | | | | | | | | | | | | |
| Large Fab <input type="checkbox"/> | Composite <input type="checkbox"/> | Supplier <input type="checkbox"/> | | | | | | | | | | | | | | | | |

| Root Cause | Date | Step | Qty | Description of work order update or Non-conformance | Initial Chief Eng | Action Description | Sign & Date | Verification | QC Inspector |
|---------------|------|------|-----|---|-------------------|--------------------|-------------|--------------|--------------|
| Doc/Data | | | | | | | | | |
| Equip/Tooling | | | | | | | | | |
| Operator | | | | | | | | | |
| Material | | | | | | | | | |
| Setup | | | | | | | | | |
| Other | | | | | | | | | |
| Process | | | | | | | | | |
| Supplier | | | | | | | | | |
| Training | | | | | | | | | |
| Unapproved | | | | | | | | | |

FAULT CATEGORY

| | | | | |
|--|---|---|--|---|
| Landing Gear <input type="checkbox"/> Bending <input type="checkbox"/> Centre Not Concentric to O/S <input type="checkbox"/> Cracks <input type="checkbox"/> Crushed/Crimped. <input type="checkbox"/> Cuffs <input type="checkbox"/> Heat Treat <input type="checkbox"/> Inspection Strip in Tube <input type="checkbox"/> Ripples in Bend <input type="checkbox"/> Torque Waves in Extrusion <input type="checkbox"/> Turning Sequence <input type="checkbox"/> Wave/Twist in Tube | General <input type="checkbox"/> Bend <input type="checkbox"/> BOM/Route <input type="checkbox"/> Broken/Damaged <input type="checkbox"/> Burrs <input type="checkbox"/> Contamination <input type="checkbox"/> Countersink <input type="checkbox"/> Cut Too Short <input type="checkbox"/> Drill Holes <input type="checkbox"/> Drawing <input type="checkbox"/> Finish <input type="checkbox"/> Folio | <input type="checkbox"/> Grain <input type="checkbox"/> Hardware <input type="checkbox"/> Inspection Incomplete <input type="checkbox"/> Instructions Incomplete/Unclear <input type="checkbox"/> Maintenance <input type="checkbox"/> Mislabeled <input type="checkbox"/> Misread <input type="checkbox"/> Offset <input type="checkbox"/> Out of Calibration <input type="checkbox"/> Out of Sequence <input type="checkbox"/> Outside Dimensions | <input type="checkbox"/> Ovalized <input type="checkbox"/> Over/Under tolerance <input type="checkbox"/> Part Incorrect <input type="checkbox"/> Part Lost/Missing <input type="checkbox"/> Part Moved <input type="checkbox"/> Positioned Wrong <input type="checkbox"/> Power Loss/Surge | <input type="checkbox"/> Pressure/Forced <input type="checkbox"/> Temperature/Cure <input type="checkbox"/> Weld <input type="checkbox"/> Wrong Stock Pulled <input type="checkbox"/> Other |
|--|---|---|--|---|

Work Order ID 96332

January-24-13 8:44:08 AM

96332

Page 5

Item ID: D3315-1 Accept ***N900040100*** Setup Start ***NS1***
Revision ID: U/R Stop ***NS2***
Item Name: Wearplate
Start Date: 1/31/13 Start Qty: 24.00 ***24*** Cust Item ID:
Required Date: 1/31/13 Req'd Qty: 24.00 ***24*** Customer:
Reference:

Approvals: Process Plan: _____ Date: _____ Tooling: _____ Date: _____ Run Start ***NR1***
QC: _____ Date: _____ SPC (Y/N): _____ Date: _____ Stop ***NR2***

| Sequence ID/ Work Center ID | Operation Description | Set Up/ Run Hours | Tool ID | Tool # | Plan Code | Accept Qty | Reject Qty | Reject Number | Insp. Stamp |
|--------------------------------|---|----------------------|---------|--------|--------------|---------------|---------------|------------------|----------------|
| 220 | QC21- Final Inspection - Work Order Release | 0.00 | | | | | | | |
| *220* | | | | | | | | | |
| QC | Memo | 0.00 | | | | | | | |
| Quality Control | | | | | | | | | |

POSITIVE RECALL
EFFECTIVE 3/24/24 AUTH W
RELEASED CP DATE 3/13/15
MLJ13-01-31

NCR: Yes / No

WORK ORDER NON-CONFORMANCE / UPDATE

DQA: _____ Date: _____

QA Closed: _____ Date: _____

| | | | | | | | | | | | | | | | | | | |
|--|---|---|--------------------------------------|------------------------------------|------------------------------------|--------------------------------------|------------------------------------|------------------------------------|--|----------------------------------|--|------------------------------------|--|--------------------------------|------------------------------------|------------------------------------|-----------------------------------|--|
| Work Order: _____ Part No. _____ NCR No. _____ | DISPOSITION Rework <input type="checkbox"/> Scrap <input type="checkbox"/> Use-as-is <input type="checkbox"/> Work Order Update <input type="checkbox"/> | AGAINST DEPARTMENT/PROCESS <table style="width: 100%;"> <tr> <td>Skid-tube <input type="checkbox"/></td> <td>Crosstube <input type="checkbox"/></td> <td>Water Jet <input type="checkbox"/></td> <td>Engineering <input type="checkbox"/></td> </tr> <tr> <td>Machining <input type="checkbox"/></td> <td>Small Fab <input type="checkbox"/></td> <td>Prod. Eng. Coord. <input type="checkbox"/></td> <td>Quality <input type="checkbox"/></td> </tr> <tr> <td>Thermoforming <input type="checkbox"/></td> <td>Finishing <input type="checkbox"/></td> <td>Rec/Store/Packaging <input type="checkbox"/></td> <td>Other <input type="checkbox"/></td> </tr> <tr> <td>Large Fab <input type="checkbox"/></td> <td>Composite <input type="checkbox"/></td> <td>Supplier <input type="checkbox"/></td> <td></td> </tr> </table> | Skid-tube <input type="checkbox"/> | Crosstube <input type="checkbox"/> | Water Jet <input type="checkbox"/> | Engineering <input type="checkbox"/> | Machining <input type="checkbox"/> | Small Fab <input type="checkbox"/> | Prod. Eng. Coord. <input type="checkbox"/> | Quality <input type="checkbox"/> | Thermoforming <input type="checkbox"/> | Finishing <input type="checkbox"/> | Rec/Store/Packaging <input type="checkbox"/> | Other <input type="checkbox"/> | Large Fab <input type="checkbox"/> | Composite <input type="checkbox"/> | Supplier <input type="checkbox"/> | |
| Skid-tube <input type="checkbox"/> | Crosstube <input type="checkbox"/> | Water Jet <input type="checkbox"/> | Engineering <input type="checkbox"/> | | | | | | | | | | | | | | | |
| Machining <input type="checkbox"/> | Small Fab <input type="checkbox"/> | Prod. Eng. Coord. <input type="checkbox"/> | Quality <input type="checkbox"/> | | | | | | | | | | | | | | | |
| Thermoforming <input type="checkbox"/> | Finishing <input type="checkbox"/> | Rec/Store/Packaging <input type="checkbox"/> | Other <input type="checkbox"/> | | | | | | | | | | | | | | | |
| Large Fab <input type="checkbox"/> | Composite <input type="checkbox"/> | Supplier <input type="checkbox"/> | | | | | | | | | | | | | | | | |

| Root Cause | Date | Step | Qty | Description of work order update or Non-conformance | Initial Chief Eng | Action Description | Sign & Date | Verification | QC Inspector |
|---------------|------|------|-----|---|-------------------|--------------------|-------------|--------------|--------------|
| Doc/Data | | | | | | | | | |
| Equip/Tooling | | | | | | | | | |
| Operator | | | | | | | | | |
| Material | | | | | | | | | |
| Setup | | | | | | | | | |
| Other | | | | | | | | | |
| Process | | | | | | | | | |
| Supplier | | | | | | | | | |
| Training | | | | | | | | | |
| Unapproved | | | | | | | | | |

FAULT CATEGORY

| | | | | |
|---|---|---|--|---|
| Landing Gear <input type="checkbox"/> Bending <input type="checkbox"/> Centre Not Concentric to O/S <input type="checkbox"/> Cracks <input type="checkbox"/> Crushed/Crimped <input type="checkbox"/> Cuffs <input type="checkbox"/> Heat Treat <input type="checkbox"/> Inspection Strip in Tube <input type="checkbox"/> Ripples in Bend <input type="checkbox"/> Torque Waves in Extrusion <input type="checkbox"/> Turning Sequence <input type="checkbox"/> Wave/Twist in Tube | General <input type="checkbox"/> Bend <input type="checkbox"/> BOM/Route <input type="checkbox"/> Broken/Damaged <input type="checkbox"/> Burrs <input type="checkbox"/> Contamination <input type="checkbox"/> Countersink <input type="checkbox"/> Cut Too Short <input type="checkbox"/> Drill Holes <input type="checkbox"/> Drawing <input type="checkbox"/> Finish <input type="checkbox"/> Folio | <input type="checkbox"/> Grain <input type="checkbox"/> Hardware <input type="checkbox"/> Inspection Incomplete <input type="checkbox"/> Instructions Incomplete/Unclear <input type="checkbox"/> Maintenance <input type="checkbox"/> Mislabeled <input type="checkbox"/> Misread <input type="checkbox"/> Offset <input type="checkbox"/> Out of Calibration <input type="checkbox"/> Out of Sequence <input type="checkbox"/> Outside Dimensions | <input type="checkbox"/> Ovalized <input type="checkbox"/> Over/Under tolerance <input type="checkbox"/> Part Incorrect <input type="checkbox"/> Part Lost/Missing <input type="checkbox"/> Part Moved <input type="checkbox"/> Positioned Wrong <input type="checkbox"/> Power Loss/Surge | <input type="checkbox"/> Pressure/Forced <input type="checkbox"/> Temperature/Cure <input type="checkbox"/> Weld <input type="checkbox"/> Wrong Stock Pulled <input type="checkbox"/> Other |
|---|---|---|--|---|

Picklist Print

January-24-13 8:44:08 AM

Page 1

Work Order ID: 96332

Parent Item: D3315-1

Parent Item Name: Wearplate

Start Date: 1/31/13

Required Date: 1/31/13

Start Qty: 24.00

Required Qty: 24.00

Comments: IPP: A05.05.12New issueKJ/JLM
IPP Rev:B As per Rev B 06-03-24 JLM
IPP Rev:C now water jet 07-12-06 DD

| Component Item ID/ Item Name | Replacement Item ID | Mfg/ Purch | Bin Item | Primary Location | Last Location | Route Seq ID | Unit of Measure | Qty on Hand | Qty per Kit | Total Qty | Qty Issued | Date Issued | Status |
|------------------------------------|------------------------|---------------|-------------|---------------------|------------------|-----------------|--------------------|----------------|-------------|------------------------|---------------|----------------|--------|
| M1010S16GA 1010/1025 sheet 16GA | | Purchased | No | | | 100 | sf | 147.8000 | 1.695 | 42375 32 | | | |
| | | | | <u>Location</u> | | <u>Loc Qty</u> | <u>Loc Code</u> | | | | | | |
| | | | | MAT019 | | 147.8 | | | | | | | |
| | | | | 124193 | | 76.3 | | | | | | | |
| | | | | 124254 | | 71.5 | | | | | | | |
| | | | | 124524 | | | | | | 124524 | | | |

NCR: Yes / No

WORK ORDER NON-CONFORMANCE / UPDATE

DQA: _____ Date: _____

QA Closed: _____ Date: _____

| | | | | | | | | | | | | | | | | | | |
|--|---|---|--------------------------------------|------------------------------------|------------------------------------|--------------------------------------|------------------------------------|------------------------------------|--|----------------------------------|--|------------------------------------|--|--------------------------------|------------------------------------|------------------------------------|-----------------------------------|--|
| Work Order: _____ Part No. _____ NCR No. _____ | DISPOSITION Rework <input type="checkbox"/> Scrap <input type="checkbox"/> Use-as-is <input type="checkbox"/> Work Order Update <input type="checkbox"/> | AGAINST DEPARTMENT/PROCESS <table style="width: 100%;"> <tr> <td>Skid-tube <input type="checkbox"/></td> <td>Crosstube <input type="checkbox"/></td> <td>Water Jet <input type="checkbox"/></td> <td>Engineering <input type="checkbox"/></td> </tr> <tr> <td>Machining <input type="checkbox"/></td> <td>Small Fab <input type="checkbox"/></td> <td>Prod. Eng. Coord. <input type="checkbox"/></td> <td>Quality <input type="checkbox"/></td> </tr> <tr> <td>Thermoforming <input type="checkbox"/></td> <td>Finishing <input type="checkbox"/></td> <td>Rec/Store/Packaging <input type="checkbox"/></td> <td>Other <input type="checkbox"/></td> </tr> <tr> <td>Large Fab <input type="checkbox"/></td> <td>Composite <input type="checkbox"/></td> <td>Supplier <input type="checkbox"/></td> <td></td> </tr> </table> | Skid-tube <input type="checkbox"/> | Crosstube <input type="checkbox"/> | Water Jet <input type="checkbox"/> | Engineering <input type="checkbox"/> | Machining <input type="checkbox"/> | Small Fab <input type="checkbox"/> | Prod. Eng. Coord. <input type="checkbox"/> | Quality <input type="checkbox"/> | Thermoforming <input type="checkbox"/> | Finishing <input type="checkbox"/> | Rec/Store/Packaging <input type="checkbox"/> | Other <input type="checkbox"/> | Large Fab <input type="checkbox"/> | Composite <input type="checkbox"/> | Supplier <input type="checkbox"/> | |
| Skid-tube <input type="checkbox"/> | Crosstube <input type="checkbox"/> | Water Jet <input type="checkbox"/> | Engineering <input type="checkbox"/> | | | | | | | | | | | | | | | |
| Machining <input type="checkbox"/> | Small Fab <input type="checkbox"/> | Prod. Eng. Coord. <input type="checkbox"/> | Quality <input type="checkbox"/> | | | | | | | | | | | | | | | |
| Thermoforming <input type="checkbox"/> | Finishing <input type="checkbox"/> | Rec/Store/Packaging <input type="checkbox"/> | Other <input type="checkbox"/> | | | | | | | | | | | | | | | |
| Large Fab <input type="checkbox"/> | Composite <input type="checkbox"/> | Supplier <input type="checkbox"/> | | | | | | | | | | | | | | | | |

| Root Cause | Date | Step | Qty | Description of work order update or Non-conformance | Initial Chief Eng | Action Description | Sign & Date | Verification | QC Inspector |
|---------------|------|------|-----|---|-------------------|--------------------|-------------|--------------|--------------|
| Doc/Data | | | | | | | | | |
| Equip/Tooling | | | | | | | | | |
| Operator | | | | | | | | | |
| Material | | | | | | | | | |
| Setup | | | | | | | | | |
| Other | | | | | | | | | |
| Process | | | | | | | | | |
| Supplier | | | | | | | | | |
| Training | | | | | | | | | |
| Unapproved | | | | | | | | | |

FAULT CATEGORY

| | | | | |
|--|---|---|--|---|
| Landing Gear <input type="checkbox"/> Bending <input type="checkbox"/> Centre Not Concentric to O/S <input type="checkbox"/> Cracks <input type="checkbox"/> Crushed/Crimped. <input type="checkbox"/> Cuffs <input type="checkbox"/> Heat Treat <input type="checkbox"/> Inspection Strip in Tube <input type="checkbox"/> Ripples in Bend <input type="checkbox"/> Torque Waves in Extrusion <input type="checkbox"/> Turning Sequence <input type="checkbox"/> Wave/Twist in Tube | General <input type="checkbox"/> Bend <input type="checkbox"/> BOM/Route <input type="checkbox"/> Broken/Damaged <input type="checkbox"/> Burrs <input type="checkbox"/> Contamination <input type="checkbox"/> Countersink <input type="checkbox"/> Cut Too Short <input type="checkbox"/> Drill Holes <input type="checkbox"/> Drawing <input type="checkbox"/> Finish <input type="checkbox"/> Folio | <input type="checkbox"/> Grain <input type="checkbox"/> Hardware <input type="checkbox"/> Inspection Incomplete <input type="checkbox"/> Instructions Incomplete/Unclear <input type="checkbox"/> Maintenance <input type="checkbox"/> Mislabeled <input type="checkbox"/> Misread <input type="checkbox"/> Offset <input type="checkbox"/> Out of Calibration <input type="checkbox"/> Out of Sequence <input type="checkbox"/> Outside Dimensions | <input type="checkbox"/> Ovalized <input type="checkbox"/> Over/Under tolerance <input type="checkbox"/> Part Incorrect <input type="checkbox"/> Part Lost/Missing <input type="checkbox"/> Part Moved <input type="checkbox"/> Positioned Wrong <input type="checkbox"/> Power Loss/Surge | <input type="checkbox"/> Pressure/Forced <input type="checkbox"/> Temperature/Cure <input type="checkbox"/> Weld <input type="checkbox"/> Wrong Stock Pulled <input type="checkbox"/> Other |
|--|---|---|--|---|

| | | | |
|-------------------------------|--------------------------|---------------------|---------|
| DART AEROSPACE LTD | | Work Order: | |
| Description: Wearplate | | Part Number: | D3315-1 |
| Inspection Dwg: D3315 | Rev: B <i>PC2</i> | Page 1 of 1 | |

FIRST ARTICLE INSPECTION CHECKLIST

☒ First Article ☐ Prototype

| Drawing Dimension | Tolerance | Actual Dimension | Accept | Reject | Method of Inspection | Comments |
|-------------------|--------------------------|------------------|--------|--------|----------------------|----------|
| Ø0.266 x 0.450 | +0.006/-0.001 x +/-0.010 | 0.266" x 0.451" | ✓ | | V | Jk moi |
| 4.402 | +/-0.010 | 4.402" | - | | V | |
| 4.137 4.262 | +/-0.010 | 4.262" | + | | V | |
| 3.550 | +/-0.010 | 3.559" | - | | V | |
| 5.464 | +/-0.010 | 5.466" | - | | V | |
| 5.214 | +/-0.010 | 5.215" | - | | V | |
| 1.224 1.348 | +/-0.010 | 1.348" | - | | V | |
| 2.572 2.45 | +/-0.030 | 2.45" | - | | V | |
| 6.273 6.350 | +/-0.010 | 6.354" | ✓ | | V | |
| 8.224 8.348 | +/-0.010 | 8.348" | - | | V | Produtor |
| 9.515 9.639 | +/-0.010 | 9.639" | - | | V | |
| 11.429 11.553 | +/-0.010 | 11.553" | - | | V | |
| 15.474 15.598 | +/-0.010 | 15.598" | - | | T | |
| 16.379 16.503 | +/-0.010 | 16.503" | - | | T | |
| 21.360 21.484 | +/-0.010 | 21.484" | - | | T | |
| 23.474 23.598 | +/-0.010 | 23.598" | - | | T | |
| 26.273 26.397 | +/-0.010 | 26.397" | - | | T | |
| 29.42 | +/-0.030 | 29.42" | - | | T | |
| 0.060 | +/-0.010 | 0.057" | - | | V | |
| Ø0.300 | +0.006/-0.001 | 0.301" | - | | V | |

| | | | |
|------------------------|-------------------------|----------------------------|-----|
| Measured by: Jm | Audited by: DAS | Prototype Approval: | N/A |
| Date: 13-1-24 | Date: 16 13/1/25 | Date: | N/A |

| Rev | Date | Change | Revised by | Approved |
|-----|----------|-----------|------------|--------------------|
| A | 09.09.28 | New Issue | KJ | <i>[Signature]</i> |

NCR: Yes / No

WORK ORDER NON-CONFORMANCE / UPDATE


DQA: _____ Date: _____

QA Closed: _____ Date: _____

| Work Order: _____ Part No. _____ NCR No. _____ | | | | DISPOSITION Rework <input type="checkbox"/> Scrap <input type="checkbox"/> Use-as-is <input type="checkbox"/> Work Order Update <input type="checkbox"/> | | AGAINST DEPARTMENT/PROCESS <div style="display: flex; justify-content: space-between;"> <div> Skid-tube <input type="checkbox"/> Machining <input type="checkbox"/> Thermoforming <input type="checkbox"/> Large Fab <input type="checkbox"/> </div> <div> Crosstube <input type="checkbox"/> Small Fab <input type="checkbox"/> Finishing <input type="checkbox"/> Composite <input type="checkbox"/> </div> <div> Water Jet <input type="checkbox"/> Prod. Eng. Coord. <input type="checkbox"/> Rec/Store/Packaging <input type="checkbox"/> Supplier <input type="checkbox"/> </div> <div> Engineering <input type="checkbox"/> Quality <input type="checkbox"/> Other <input type="checkbox"/> </div> </div> | | | | | |
|--|------|------|-----|---|-------------------|---|-------------|--------------|--------------|--|--|
| Root Cause | Date | Step | Qty | Description of work order update or Non-conformance | Initial Chief Eng | Action Description | Sign & Date | Verification | QC Inspector | | |
| Doc/Data <input type="checkbox"/> | | | | | | | | | | | |
| Equip/Tooling <input type="checkbox"/> | | | | | | | | | | | |
| Operator <input type="checkbox"/> | | | | | | | | | | | |
| Material <input type="checkbox"/> | | | | | | | | | | | |
| Setup <input type="checkbox"/> | | | | | | | | | | | |
| Other <input type="checkbox"/> | | | | | | | | | | | |
| Process <input type="checkbox"/> | | | | | | | | | | | |
| Supplier <input type="checkbox"/> | | | | | | | | | | | |
| Training <input type="checkbox"/> | | | | | | | | | | | |
| Unapproved <input type="checkbox"/> | | | | | | | | | | | |

| FAULT CATEGORY | | | |
|--|---|---|---|
| Landing Gear <input type="checkbox"/> Bending <input type="checkbox"/> Centre Not Concentric to O/S <input type="checkbox"/> Cracks <input type="checkbox"/> Crushed/Crimped. <input type="checkbox"/> Cuffs <input type="checkbox"/> Heat Treat <input type="checkbox"/> Inspection Strip in Tube <input type="checkbox"/> Ripples in Bend <input type="checkbox"/> Torque Waves in Extrusion <input type="checkbox"/> Turning Sequence <input type="checkbox"/> Wave/Twist in Tube | General <input type="checkbox"/> Bend <input type="checkbox"/> BOM/Route <input type="checkbox"/> Broken/Damaged <input type="checkbox"/> Burrs <input type="checkbox"/> Contamination <input type="checkbox"/> Countersink <input type="checkbox"/> Cut Too Short <input type="checkbox"/> Drill Holes <input type="checkbox"/> Drawing <input type="checkbox"/> Finish <input type="checkbox"/> Folio | <input type="checkbox"/> Grain <input type="checkbox"/> Hardware <input type="checkbox"/> Inspection Incomplete <input type="checkbox"/> Instructions Incomplete/Unclear <input type="checkbox"/> Maintenance <input type="checkbox"/> Mislabeled <input type="checkbox"/> Misread <input type="checkbox"/> Offset <input type="checkbox"/> Out of Calibration <input type="checkbox"/> Out of Sequence <input type="checkbox"/> Outside Dimensions | <input type="checkbox"/> Ovalized <input type="checkbox"/> Over/Under tolerance <input type="checkbox"/> Part Incorrect <input type="checkbox"/> Part Lost/Missing <input type="checkbox"/> Part Moved <input type="checkbox"/> Positioned Wrong <input type="checkbox"/> Power Loss/Surge <input type="checkbox"/> Pressure/Forced <input type="checkbox"/> Temperature/Cure <input type="checkbox"/> Weld <input type="checkbox"/> Wrong Stock Pulled <input type="checkbox"/> Other |

13.01.22

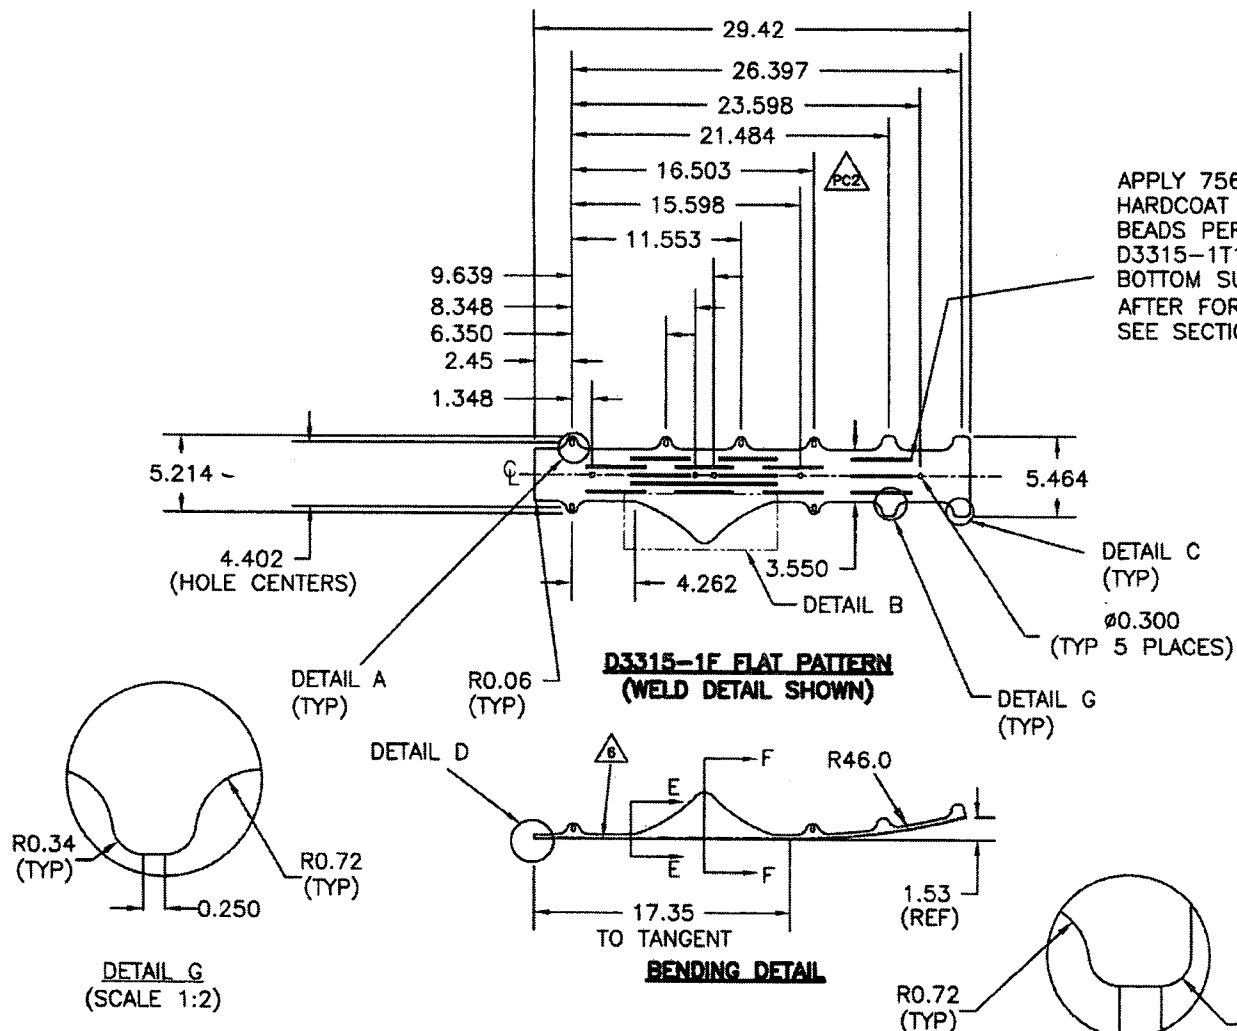

D3315-1 WEARPLATE SHOWN (-2 OPPOSITE)

- 1) MATERIAL: AISI 1010-1025 OR ASTM A36/A366/A1008 OR CSA G40-21, 38W/44W/50W/60W/70W SERIES STEEL 16 GAUGE (0.060 THICK)
 - 2) FINISH: POWDER COAT GREY SANDTEX (REF.4.3.5.6) PER DART QSI 005 4.3
 - 3) WELD PER DART QSI 004
 - 4) TOLERANCES ARE PER DART QSI 018 UNLESS OTHERWISE NOTED
 - 5) ALL DIMENSIONS ARE IN INCHES
 - 6) IDENTIFY ON INSIDE SURFACE AS INDICATED
- "TCCA-PDA, DART AEROSPACE LTD., P/N D3315-X
B/N BXXXXX, FOR PRODUCT ELIGIBILITY SEE PDA05-17"

| DESIGN | DRAWN BY | DART AEROSPACE LTD |
|---------------|-----------------|--------------------------------|
| CHECKED | APPROVED | DRAWING NO. D3315 |
| DATE 13.01.22 | TITLE WEARPLATE | REV. PC2 |
| A | 04.09.10 | NEW ISSUE |
| B | 06.01.31 | UPDATE DIMENSIONS |
| PC1 | 13.01.21 | RE-DESIGN -1F. REF: NCR12-1750 |
| PC2 | 13.01.212 | 16.503 WAS 16.653 |

Copyright © 2004 by DART AEROSPACE LTD
THIS DOCUMENT IS PRIVATE AND CONFIDENTIAL AND IS SUPPLIED ON THE EXPRESS CONDITION THAT IT IS NOT TO BE USED FOR ANY PURPOSE OR COPIED OR COMMUNICATED TO ANY OTHER PERSON WITHOUT WRITTEN PERMISSION FROM DART AEROSPACE LTD.

1096332

NCR: Yes / No


WORK ORDER NON-CONFORMANCE / UPDATE

DQA: _____ Date: _____

QA Closed: _____ Date: _____

| | | | | | | | | | | | |
|---|------|------|---|---|----------------------|---|----------------|--------------|---|--|--|
| Work Order: _____ Part No. _____ NCR No. _____ | | | | DISPOSITION Rework <input type="checkbox"/> Scrap <input type="checkbox"/> Use-as-is <input type="checkbox"/> Work Order Update <input type="checkbox"/> | | AGAINST DEPARTMENT/PROCESS <div style="display: flex; justify-content: space-between;"> <div> Skid-tube <input type="checkbox"/> Machining <input type="checkbox"/> Thermoforming <input type="checkbox"/> Large Fab <input type="checkbox"/> </div> <div> Crosstube <input type="checkbox"/> Small Fab <input type="checkbox"/> Finishing <input type="checkbox"/> Composite <input type="checkbox"/> </div> <div> Water Jet <input type="checkbox"/> Prod. Eng. Coord. <input type="checkbox"/> Rec/Store/Packaging <input type="checkbox"/> Supplier <input type="checkbox"/> </div> <div> Engineering <input type="checkbox"/> Quality <input type="checkbox"/> Other <input type="checkbox"/> </div> </div> | | | | | |
| Root Cause | Date | Step | Qty | Description of work order update or Non-conformance | Initial Chief Eng | Action Description | Sign & Date | Verification | QC Inspector | | |
| Doc/Data <input type="checkbox"/> | | | | | | | | | | | |
| Equip/Tooling <input type="checkbox"/> | | | | | | | | | | | |
| Operator <input type="checkbox"/> | | | | | | | | | | | |
| Material <input type="checkbox"/> | | | | | | | | | | | |
| Setup <input type="checkbox"/> | | | | | | | | | | | |
| Other <input type="checkbox"/> | | | | | | | | | | | |
| Process <input type="checkbox"/> | | | | | | | | | | | |
| Supplier <input type="checkbox"/> | | | | | | | | | | | |
| Training <input type="checkbox"/> | | | | | | | | | | | |
| Unapproved <input type="checkbox"/> | | | | | | | | | | | |
| FAULT CATEGORY | | | | | | | | | | | |
| Landing Gear <input type="checkbox"/> Bending <input type="checkbox"/> Centre Not Concentric to O/S <input type="checkbox"/> Cracks <input type="checkbox"/> Crushed/Crimped <input type="checkbox"/> Cuffs <input type="checkbox"/> Heat Treat <input type="checkbox"/> Inspection Strip in Tube <input type="checkbox"/> Ripples in Bend <input type="checkbox"/> Torque Waves in Extrusion <input type="checkbox"/> Turning Sequence <input type="checkbox"/> Wave/Twist in Tube | | | General <input type="checkbox"/> Bend <input type="checkbox"/> BOM/Route <input type="checkbox"/> Broken/Damaged <input type="checkbox"/> Burrs <input type="checkbox"/> Contamination <input type="checkbox"/> Countersink <input type="checkbox"/> Cut Too Short <input type="checkbox"/> Drill Holes <input type="checkbox"/> Drawing <input type="checkbox"/> Finish <input type="checkbox"/> Folio | | | <input type="checkbox"/> Grain <input type="checkbox"/> Hardware <input type="checkbox"/> Inspection Incomplete <input type="checkbox"/> Instructions Incomplete/Unclear <input type="checkbox"/> Maintenance <input type="checkbox"/> Mislabeled <input type="checkbox"/> Misread <input type="checkbox"/> Offset <input type="checkbox"/> Out of Calibration <input type="checkbox"/> Out of Sequence <input type="checkbox"/> Outside Dimensions | | | <input type="checkbox"/> Ovalized <input type="checkbox"/> Over/Under tolerance <input type="checkbox"/> Part Incorrect <input type="checkbox"/> Part Lost/Missing <input type="checkbox"/> Part Moved <input type="checkbox"/> Positioned Wrong <input type="checkbox"/> Power Loss/Surge <input type="checkbox"/> Pressure/Forced <input type="checkbox"/> Temperature/Cure <input type="checkbox"/> Weld <input type="checkbox"/> Wrong Stock Pulled <input type="checkbox"/> Other | | |

13.01.22

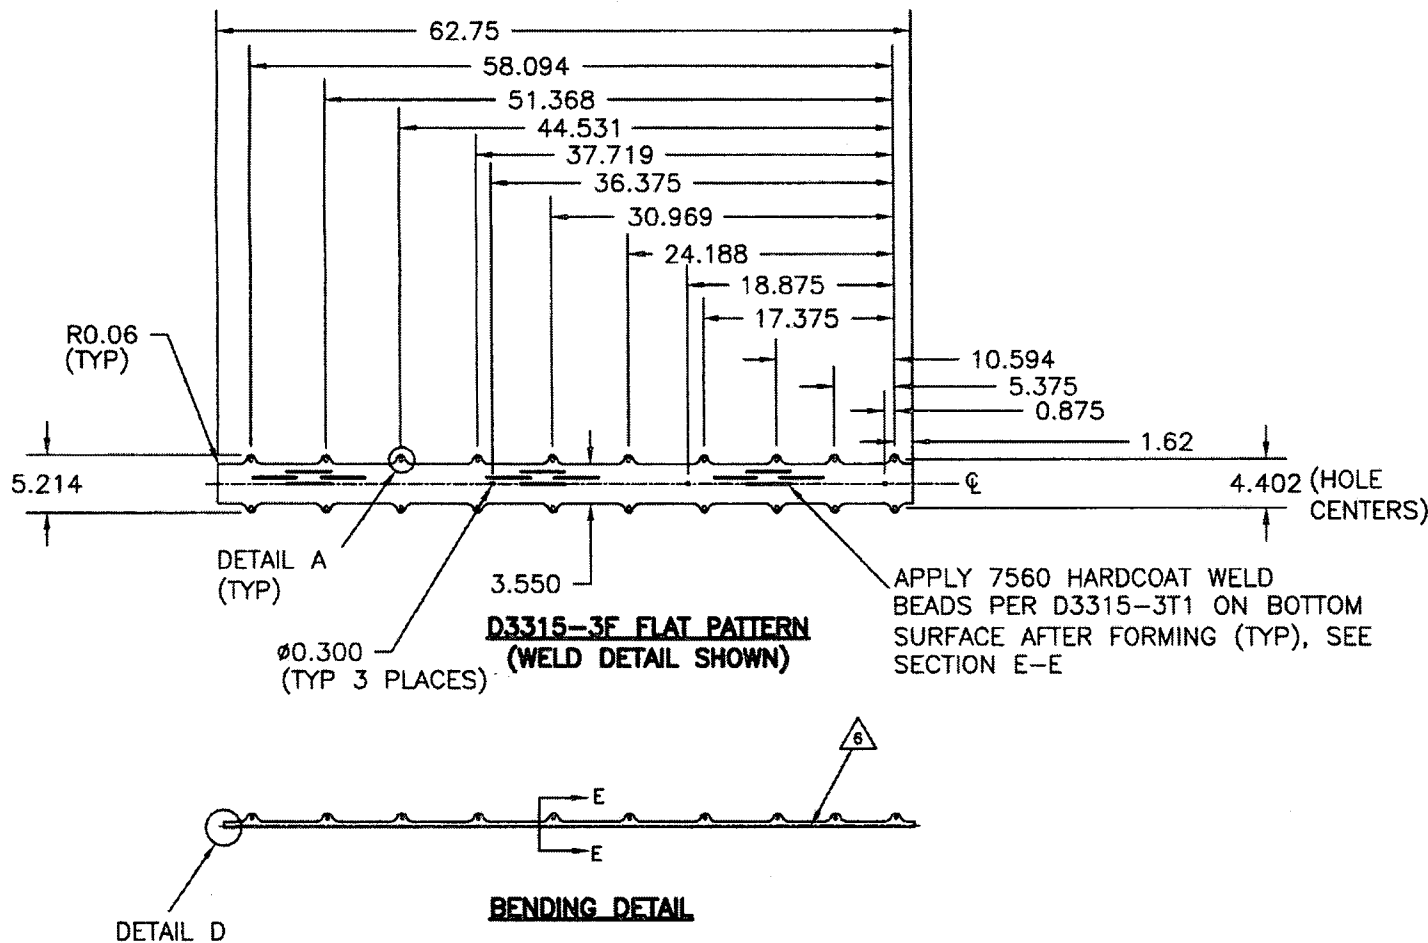

D3315-3 WEARPLATE SHOWN (-4 OPPOSITE)

- 1) MATERIAL: AISI 1010-1025 OR ASTM A36/A366/A1008 OR CSA G40-21, 38W/44W/50W/60W/70W SERIES STEEL 16 GAUGE (0.060 THICK)
- 2) FINISH: POWDER COAT GREY SANDTEX (REF.4.3.5.6) PER DART QSI 005 4.3
- 3) WELD PER DART QSI 004
- 4) TOLERANCES ARE PER DART QSI 018 UNLESS OTHERWISE NOTED
- 5) ALL DIMENSIONS ARE IN INCHES
- 6) IDENTIFY ON INSIDE SURFACE AS INDICATED
"TCCA-PDA, DART AEROSPACE LTD., P/N D3315-X
B/N BXXXXX, FOR PRODUCT ELIGIBILITY SEE PDA05-17"

| | | |
|----------|-------------|-----------------------------|
| DESIGN | DRAWN BY | DART AEROSPACE LTD |
| CHECKED | APPROVED | HAWKESBURY, ONTARIO, CANADA |
| DATE | DRAWING NO. | REV. PC2 |
| 13.01.22 | D3315 | SHEET 2 OF 4 |
| | TITLE | SCALE |
| | WEARPLATE | 1:16 |

NCR: Yes / No

WORK ORDER NON-CONFORMANCE / UPDATE

DQA: _____ Date: _____

QA Closed: _____ Date: _____


| | | |
|--|---|---|
| Work Order: _____ Part No. _____ NCR No. _____ | DISPOSITION Rework <input type="checkbox"/> Scrap <input type="checkbox"/> Use-as-is <input type="checkbox"/> Work Order Update <input type="checkbox"/> | AGAINST DEPARTMENT/PROCESS <div style="display: flex; justify-content: space-between;"> <div> Skid-tube <input type="checkbox"/> Machining <input type="checkbox"/> Thermoforming <input type="checkbox"/> Large Fab <input type="checkbox"/> </div> <div> Crosstube <input type="checkbox"/> Small Fab <input type="checkbox"/> Finishing <input type="checkbox"/> Composite <input type="checkbox"/> </div> <div> Water Jet <input type="checkbox"/> Prod. Eng. Coord. <input type="checkbox"/> Rec/Store/Packaging <input type="checkbox"/> Supplier <input type="checkbox"/> </div> <div> Engineering <input type="checkbox"/> Quality <input type="checkbox"/> Other <input type="checkbox"/> </div> </div> |
|--|---|---|

| Root Cause | Date | Step | Qty | Description of work order update or Non-conformance | Initial Chief Eng | Action Description | Sign & Date | Verification | QC Inspector |
|---------------|------|------|-----|---|-------------------|--------------------|-------------|--------------|--------------|
| Doc/Data | | | | | | | | | |
| Equip/Tooling | | | | | | | | | |
| Operator | | | | | | | | | |
| Material | | | | | | | | | |
| Setup | | | | | | | | | |
| Other | | | | | | | | | |
| Process | | | | | | | | | |
| Supplier | | | | | | | | | |
| Training | | | | | | | | | |
| Unapproved | | | | | | | | | |

FAULT CATEGORY



| | | | | |
|---|---|---|--|---|
| Landing Gear <input type="checkbox"/> Bending <input type="checkbox"/> Centre Not Concentric to O/S <input type="checkbox"/> Cracks <input type="checkbox"/> Crushed/Crimped <input type="checkbox"/> Cuffs <input type="checkbox"/> Heat Treat <input type="checkbox"/> Inspection Strip in Tube <input type="checkbox"/> Ripples in Bend <input type="checkbox"/> Torque Waves in Extrusion <input type="checkbox"/> Turning Sequence <input type="checkbox"/> Wave/Twist in Tube | General <input type="checkbox"/> Bend <input type="checkbox"/> BOM/Route <input type="checkbox"/> Broken/Damaged <input type="checkbox"/> Burrs <input type="checkbox"/> Contamination <input type="checkbox"/> Countersink <input type="checkbox"/> Cut Too Short <input type="checkbox"/> Drill Holes <input type="checkbox"/> Drawing <input type="checkbox"/> Finish <input type="checkbox"/> Folio | <input type="checkbox"/> Grain <input type="checkbox"/> Hardware <input type="checkbox"/> Inspection Incomplete <input type="checkbox"/> Instructions Incomplete/Unclear <input type="checkbox"/> Maintenance <input type="checkbox"/> Mislabeled <input type="checkbox"/> Misread <input type="checkbox"/> Offset <input type="checkbox"/> Out of Calibration <input type="checkbox"/> Out of Sequence <input type="checkbox"/> Outside Dimensions | <input type="checkbox"/> Ovalized <input type="checkbox"/> Over/Under tolerance <input type="checkbox"/> Part Incorrect <input type="checkbox"/> Part Lost/Missing <input type="checkbox"/> Part Moved <input type="checkbox"/> Positioned Wrong <input type="checkbox"/> Power Loss/Surge | <input type="checkbox"/> Pressure/Forced <input type="checkbox"/> Temperature/Cure <input type="checkbox"/> Weld <input type="checkbox"/> Wrong Stock Pulled <input type="checkbox"/> Other |
|---|---|---|--|---|

13.01.22

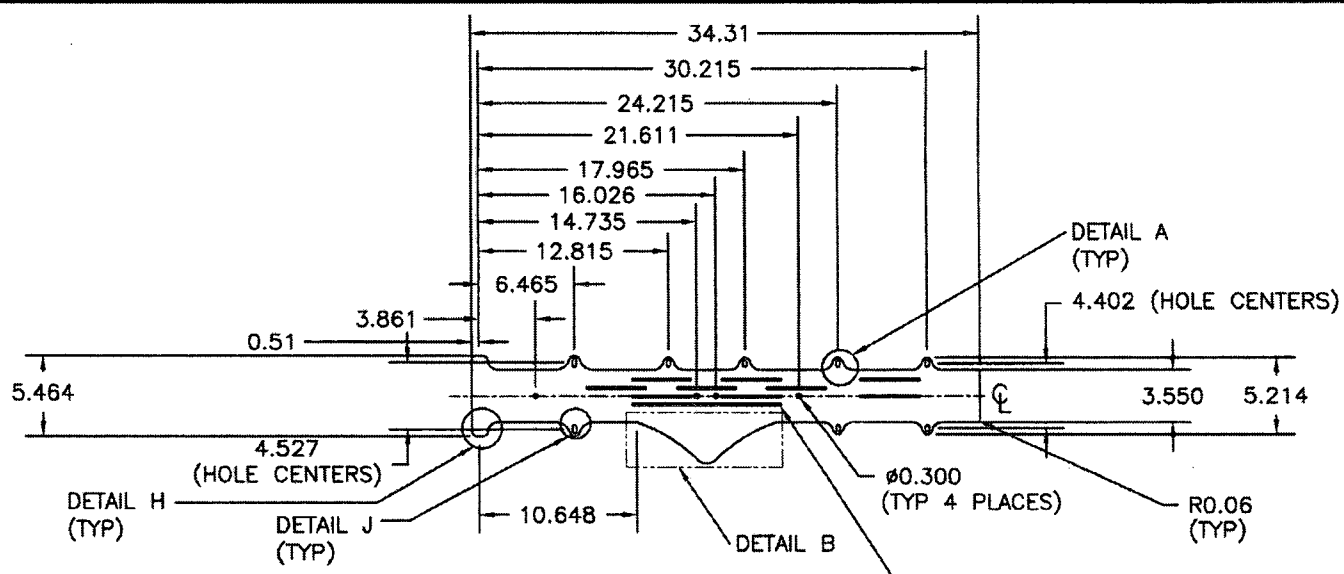


**D3315-5F FLAT PATTERN
(WELD DETAIL SHOWN)**

APPLY 7560 HARDCOAT WELD
BEADS PER D3315-5T1 ON BOTTOM SURFACE
AFTER FORMING (TYP), SEE SECTION E-E

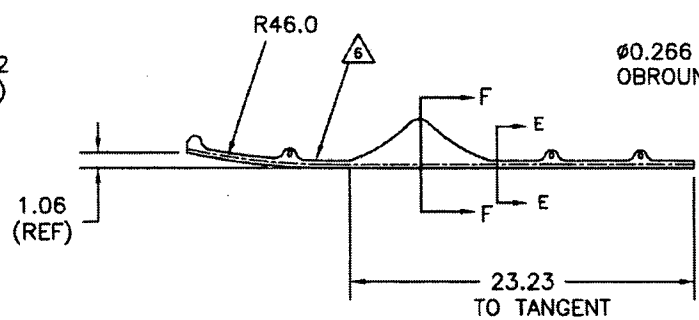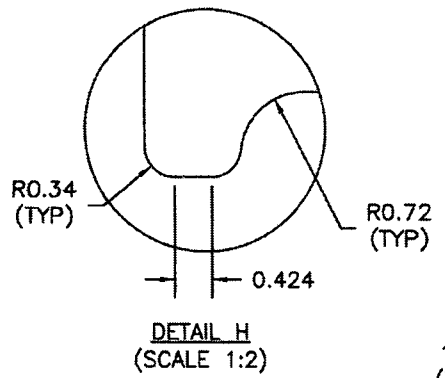

BENDING DETAIL

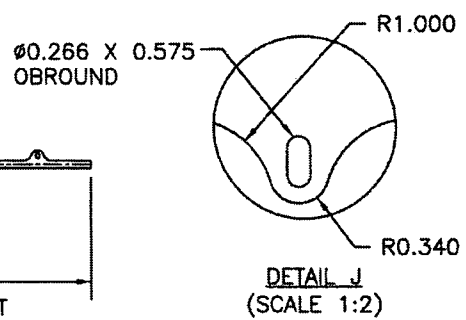

D3315-5 WEARPLATE SHOWN (-6 OPPOSITE)

- 1) MATERIAL: AISI 1010-1025 OR ASTM A36/A366/A1008 OR CSA G40-21, 38W/44W/50W/60W/70W SERIES STEEL 16 GAUGE (0.060 THICK)
 - 2) FINISH: POWDER COAT GREY SANDTEX (REF.4.3.5.6) PER DART QSI 005 4.3
 - 3) WELD PER DART QSI 004
 - 4) TOLERANCES ARE PER DART QSI 018 UNLESS OTHERWISE NOTED
 - 5) ALL DIMENSION ARE IN INCHES
 - 6) IDENTIFY ON INSIDE SURFACE AS INDICATED
- "TCCA-PDA, DART AEROSPACE LTD., P/N D3315-X
B/N BXXXXX, FOR PRODUCT ELIGIBILITY SEE PDA05-17"

| | | |
|----------|-----------|-----------------------------|
| DESIGN | DRAWN BY | DART AEROSPACE LTD |
| CHECKED | APPROVED | HAWKESBURY, ONTARIO, CANADA |
| DATE | TITLE | REV. PC2 |
| 13.01.22 | WEARPLATE | SHEET 3 OF 4 |
| | | SCALE |
| | | 1:12 |

Copyright © 2004 by DART AEROSPACE LTD
THIS DOCUMENT IS PRIVATE AND CONFIDENTIAL AND IS SUPPLIED ON THE EXPRESS CONDITION THAT IT IS NOT TO BE USED FOR ANY PURPOSE OR COPIED OR COMMUNICATED TO ANY OTHER PERSON WITHOUT WRITTEN PERMISSION FROM DART AEROSPACE LTD.

NCR: Yes / No

WORK ORDER NON-CONFORMANCE / UPDATE

DQA: _____ Date: _____

QA Closed: _____ Date: _____

| | | |
|--|---|---|
| Work Order: _____ Part No. _____ NCR No. _____ | DISPOSITION Rework <input type="checkbox"/> Scrap <input type="checkbox"/> Use-as-is <input type="checkbox"/> Work Order Update <input type="checkbox"/> | AGAINST DEPARTMENT/PROCESS <div style="display: flex; justify-content: space-between;"> <div> Skid-tube <input type="checkbox"/> Machining <input type="checkbox"/> Thermoforming <input type="checkbox"/> Large Fab <input type="checkbox"/> </div> <div> Crosstube <input type="checkbox"/> Small Fab <input type="checkbox"/> Finishing <input type="checkbox"/> Composite <input type="checkbox"/> </div> <div> Water Jet <input type="checkbox"/> Prod. Eng. Coord. <input type="checkbox"/> Rec/Store/Packaging <input type="checkbox"/> Supplier <input type="checkbox"/> </div> <div> Engineering <input type="checkbox"/> Quality <input type="checkbox"/> Other <input type="checkbox"/> </div> </div> |
|--|---|---|

| Root Cause | Date | Step | Qty | Description of work order update or Non-conformance | Initial Chief Eng | Action Description | Sign & Date | Verification | QC Inspector |
|---------------|------|------|-----|---|-------------------|--------------------|-------------|--------------|--------------|
| Doc/Data | | | | | | | | | |
| Equip/Tooling | | | | | | | | | |
| Operator | | | | | | | | | |
| Material | | | | | | | | | |
| Setup | | | | | | | | | |
| Other | | | | | | | | | |
| Process | | | | | | | | | |
| Supplier | | | | | | | | | |
| Training | | | | | | | | | |
| Unapproved | | | | | | | | | |


FAULT CATEGORY

| | | | |
|--|---|---|---|
| Landing Gear <input type="checkbox"/> Bending <input type="checkbox"/> Centre Not Concentric to O/S <input type="checkbox"/> Cracks <input type="checkbox"/> Crushed/Crimped. <input type="checkbox"/> Cuffs <input type="checkbox"/> Heat Treat <input type="checkbox"/> Inspection Strip in Tube <input type="checkbox"/> Ripples in Bend <input type="checkbox"/> Torque Waves in Extrusion <input type="checkbox"/> Turning Sequence <input type="checkbox"/> Wave/Twist in Tube | General <input type="checkbox"/> Bend <input type="checkbox"/> BOM/Route <input type="checkbox"/> Broken/Damaged <input type="checkbox"/> Burrs <input type="checkbox"/> Contamination <input type="checkbox"/> Countersink <input type="checkbox"/> Cut Too Short <input type="checkbox"/> Drill Holes <input type="checkbox"/> Drawing <input type="checkbox"/> Finish <input type="checkbox"/> Folio | <input type="checkbox"/> Grain <input type="checkbox"/> Hardware <input type="checkbox"/> Inspection Incomplete <input type="checkbox"/> Instructions Incomplete/Unclear <input type="checkbox"/> Maintenance <input type="checkbox"/> Mislabeled <input type="checkbox"/> Misread <input type="checkbox"/> Offset <input type="checkbox"/> Out of Calibration <input type="checkbox"/> Out of Sequence <input type="checkbox"/> Outside Dimensions | <input type="checkbox"/> Ovalized <input type="checkbox"/> Over/Under tolerance <input type="checkbox"/> Part Incorrect <input type="checkbox"/> Part Lost/Missing <input type="checkbox"/> Part Moved <input type="checkbox"/> Positioned Wrong <input type="checkbox"/> Power Loss/Surge <input type="checkbox"/> Pressure/Forced <input type="checkbox"/> Temperature/Cure <input type="checkbox"/> Weld <input type="checkbox"/> Wrong Stock Pulled <input type="checkbox"/> Other |
|--|---|---|---|


13.01.22
 PRELIMINARY ISSUE

| | | | |
|------------------|----------|---|--------------------------|
| DESIGN | DRAWN BY | DART AEROSPACE LTD HAWKESBURY, ONTARIO, CANADA | |
| CHECKED | APPROVED | DRAWING NO. D3315 | REV. PC2 SHEET 4 OF 4 |
| DATE 13.01.22 | | TITLE WEARPLATE | SCALE NTS |


DETAIL A
(SCALE 1:2)

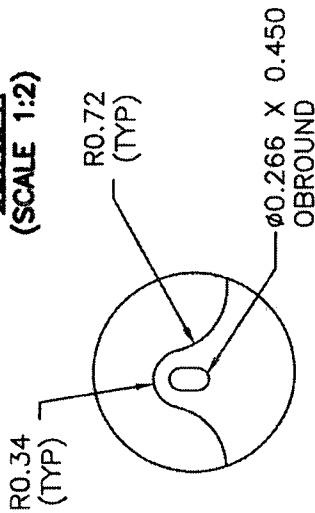


DETAIL D
(SCALE 1:2)

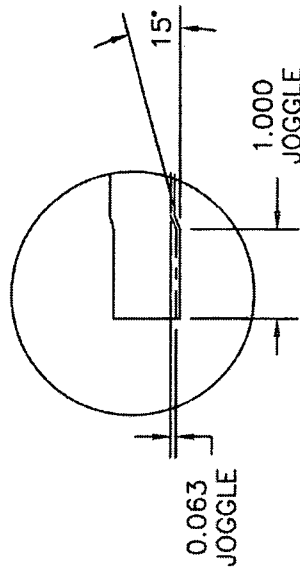


DETAIL B
(SCALE 1:4)

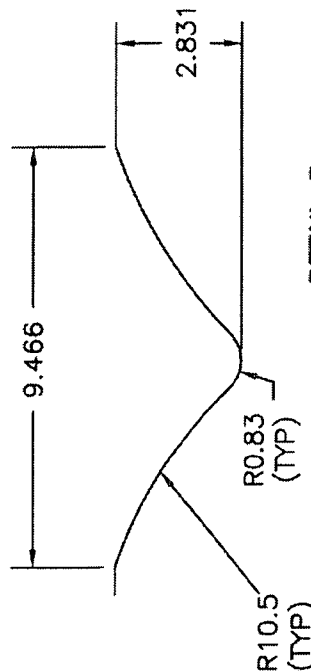

SECTION E-E
(SCALE 1:2)

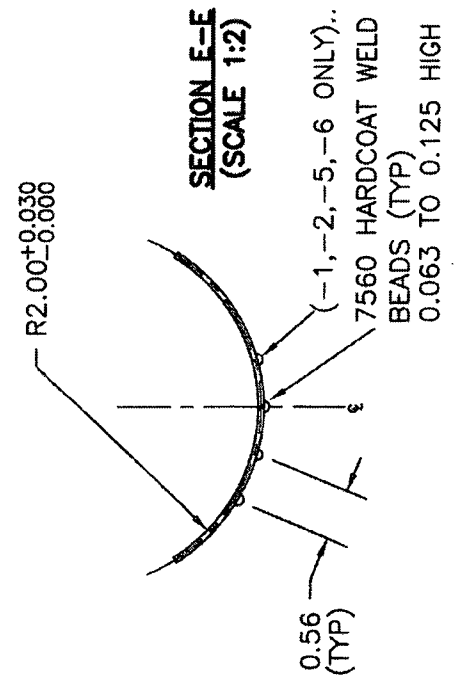

SECTION F-F
(SCALE 1:2)

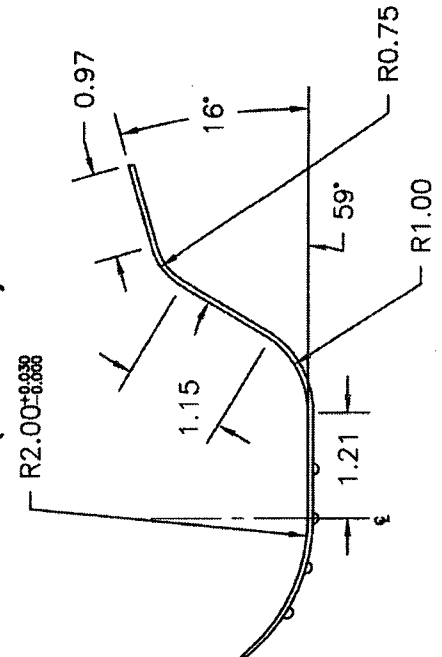

Copyright © 2004 by DART AEROSPACE LTD

THIS DOCUMENT IS PRIVATE AND CONFIDENTIAL AND IS SUPPLIED ON THE EXPRESS CONDITION THAT IT IS NOT TO BE USED FOR ANY PURPOSE OR COPIED OR COMMUNICATED TO ANY OTHER PERSON WITHOUT WRITTEN PERMISSION FROM DART AEROSPACE LTD.

NCR: Yes / No

WORK ORDER NON-CONFORMANCE / UPDATE

DQA: _____ Date: _____



QA Closed: _____ Date: _____

| | | | | | | | | | | | | | | | | | | |
|--|---|---|--------------------------------------|------------------------------------|------------------------------------|--------------------------------------|------------------------------------|------------------------------------|--|----------------------------------|--|------------------------------------|--|--------------------------------|------------------------------------|------------------------------------|-----------------------------------|--|
| Work Order: _____ Part No. _____ NCR No. _____ | DISPOSITION Rework <input type="checkbox"/> Scrap <input type="checkbox"/> Use-as-is <input type="checkbox"/> Work Order Update <input type="checkbox"/> | AGAINST DEPARTMENT/PROCESS <table style="width: 100%;"> <tr> <td>Skid-tube <input type="checkbox"/></td> <td>Crosstube <input type="checkbox"/></td> <td>Water Jet <input type="checkbox"/></td> <td>Engineering <input type="checkbox"/></td> </tr> <tr> <td>Machining <input type="checkbox"/></td> <td>Small Fab <input type="checkbox"/></td> <td>Prod. Eng. Coord. <input type="checkbox"/></td> <td>Quality <input type="checkbox"/></td> </tr> <tr> <td>Thermoforming <input type="checkbox"/></td> <td>Finishing <input type="checkbox"/></td> <td>Rec/Store/Packaging <input type="checkbox"/></td> <td>Other <input type="checkbox"/></td> </tr> <tr> <td>Large Fab <input type="checkbox"/></td> <td>Composite <input type="checkbox"/></td> <td>Supplier <input type="checkbox"/></td> <td></td> </tr> </table> | Skid-tube <input type="checkbox"/> | Crosstube <input type="checkbox"/> | Water Jet <input type="checkbox"/> | Engineering <input type="checkbox"/> | Machining <input type="checkbox"/> | Small Fab <input type="checkbox"/> | Prod. Eng. Coord. <input type="checkbox"/> | Quality <input type="checkbox"/> | Thermoforming <input type="checkbox"/> | Finishing <input type="checkbox"/> | Rec/Store/Packaging <input type="checkbox"/> | Other <input type="checkbox"/> | Large Fab <input type="checkbox"/> | Composite <input type="checkbox"/> | Supplier <input type="checkbox"/> | |
| Skid-tube <input type="checkbox"/> | Crosstube <input type="checkbox"/> | Water Jet <input type="checkbox"/> | Engineering <input type="checkbox"/> | | | | | | | | | | | | | | | |
| Machining <input type="checkbox"/> | Small Fab <input type="checkbox"/> | Prod. Eng. Coord. <input type="checkbox"/> | Quality <input type="checkbox"/> | | | | | | | | | | | | | | | |
| Thermoforming <input type="checkbox"/> | Finishing <input type="checkbox"/> | Rec/Store/Packaging <input type="checkbox"/> | Other <input type="checkbox"/> | | | | | | | | | | | | | | | |
| Large Fab <input type="checkbox"/> | Composite <input type="checkbox"/> | Supplier <input type="checkbox"/> | | | | | | | | | | | | | | | | |


| Root Cause | Date | Step | Qty | Description of work order update or Non-conformance | Initial Chief Eng | Action Description | Sign & Date | Verification | QC Inspector |
|---------------|------|------|-----|---|-------------------|--------------------|-------------|--------------|--------------|
| Doc/Data | | | | | | | | | |
| Equip/Tooling | | | | | | | | | |
| Operator | | | | | | | | | |
| Material | | | | | | | | | |
| Setup | | | | | | | | | |
| Other | | | | | | | | | |
| Process | | | | | | | | | |
| Supplier | | | | | | | | | |
| Training | | | | | | | | | |
| Unapproved | | | | | | | | | |

FAULT CATEGORY

| | | | |
|---|---|---|---|
| Landing Gear <input type="checkbox"/> Bending <input type="checkbox"/> Centre Not Concentric to O/S <input type="checkbox"/> Cracks <input type="checkbox"/> Crushed/Crimped <input type="checkbox"/> Cuffs <input type="checkbox"/> Heat Treat <input type="checkbox"/> Inspection Strip in Tube <input type="checkbox"/> Ripples in Bend <input type="checkbox"/> Torque Waves in Extrusion <input type="checkbox"/> Turning Sequence <input type="checkbox"/> Wave/Twist in Tube | General <input type="checkbox"/> Bend <input type="checkbox"/> BOM/Route <input type="checkbox"/> Broken/Damaged <input type="checkbox"/> Burrs <input type="checkbox"/> Contamination <input type="checkbox"/> Countersink <input type="checkbox"/> Cut Too Short <input type="checkbox"/> Drill Holes <input type="checkbox"/> Drawing <input type="checkbox"/> Finish <input type="checkbox"/> Folio | <input type="checkbox"/> Grain <input type="checkbox"/> Hardware <input type="checkbox"/> Inspection Incomplete <input type="checkbox"/> Instructions Incomplete/Unclear <input type="checkbox"/> Maintenance <input type="checkbox"/> Mislabeled <input type="checkbox"/> Misread <input type="checkbox"/> Offset <input type="checkbox"/> Out of Calibration <input type="checkbox"/> Out of Sequence <input type="checkbox"/> Outside Dimensions | <input type="checkbox"/> Ovalized <input type="checkbox"/> Over/Under tolerance <input type="checkbox"/> Part Incorrect <input type="checkbox"/> Part Lost/Missing <input type="checkbox"/> Part Moved <input type="checkbox"/> Positioned Wrong <input type="checkbox"/> Power Loss/Surge <input type="checkbox"/> Pressure/Forced <input type="checkbox"/> Temperature/Cure <input type="checkbox"/> Weld <input type="checkbox"/> Wrong Stock Pulled <input type="checkbox"/> Other |
|---|---|---|---|

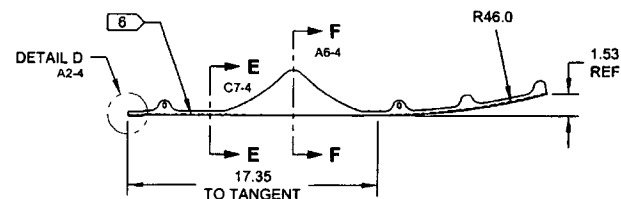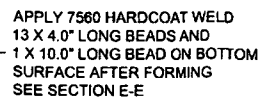

RELEASED
2013-02-14

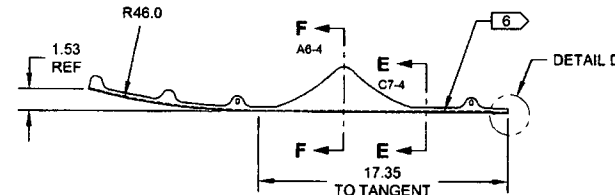

D3315-2 WEARPLATE
MAKE FROM D3315-1F

1) MATERIAL: AISI 1010-1025 OR ASTM A36/A366/A1008 OR CSA G40-21,
38W/44W/50W/60W/70W SERIES STEEL, 16 GAUGE (0.060 THICK)
REF. DART SPEC. M1010GA16

2) FINISH: POWDER COAT "GREY SANTEX" (4.3.5.6) PER DART QSI 005 4.3
3) TOLERANCES: PER DART QSI 018 UNLESS OTHERWISE NOTED

4) UNITS: INCHES UNLESS OTHERWISE NOTED

5) BREAK SHARP EDGES: 0.005 TO 0.010 MAX

6) IDENTIFICATION: IDENTIFY WITH "TCCA-PD"


 

 
 
 
PER DART QSI 044 6.5 (LABEL)


7) WEIGHT: 2.15 lbs

8) WELDING: PER D

9) WATERJET PROGRAMMING: F

9) WATERSET PROGRAMMING. PER US315-1F_REV.C.DXF

| | | | | |
|------------|--|--|---|------------|
| C | UPDATED DWG TO CURRENT STD; RE-DESIGNED -1F; CORRECTED DRAFTING ERRORS ON -5F; DIMS REVIEWED ON 1/1F-3/1F-5F. REF: NCR12-1750. | | MB | 13.01.22 |
| B | UPDATE DIMENSIONS | | PH | 06.01.31 |
| A | NEW ISSUE | | PH | 04.09.10 |
| REV. | DESCRIPTION | | BY | DATE |
| DESIGN |  | DART AEROSPACE LTD HAWKESBURY, ONTARIO, CANADA | | |
| DRAWN |  | | | |
| CHECKED |  | | DRAWING NO. | REV. |
| MFG. APPR. |  | | D3315 | SHEET 1 OF |
| APPROVED |  | | TITLE | SCALE |
| DE APPR. |  | WEARPLATE | | NT |
| DATE | 13.01.22 | | COPYRIGHT © 2004 BY DART AEROSPACE LTD THIS DOCUMENT IS PRINTED AND COPIED/REPRODUCED FROM THE CONTROL DRAWING THAT IT IS NOT TO BE USED FOR ANY PURPOSE OR COPIED OR REPRODUCED TO ANY OTHER PERSON WITHOUT IT | |

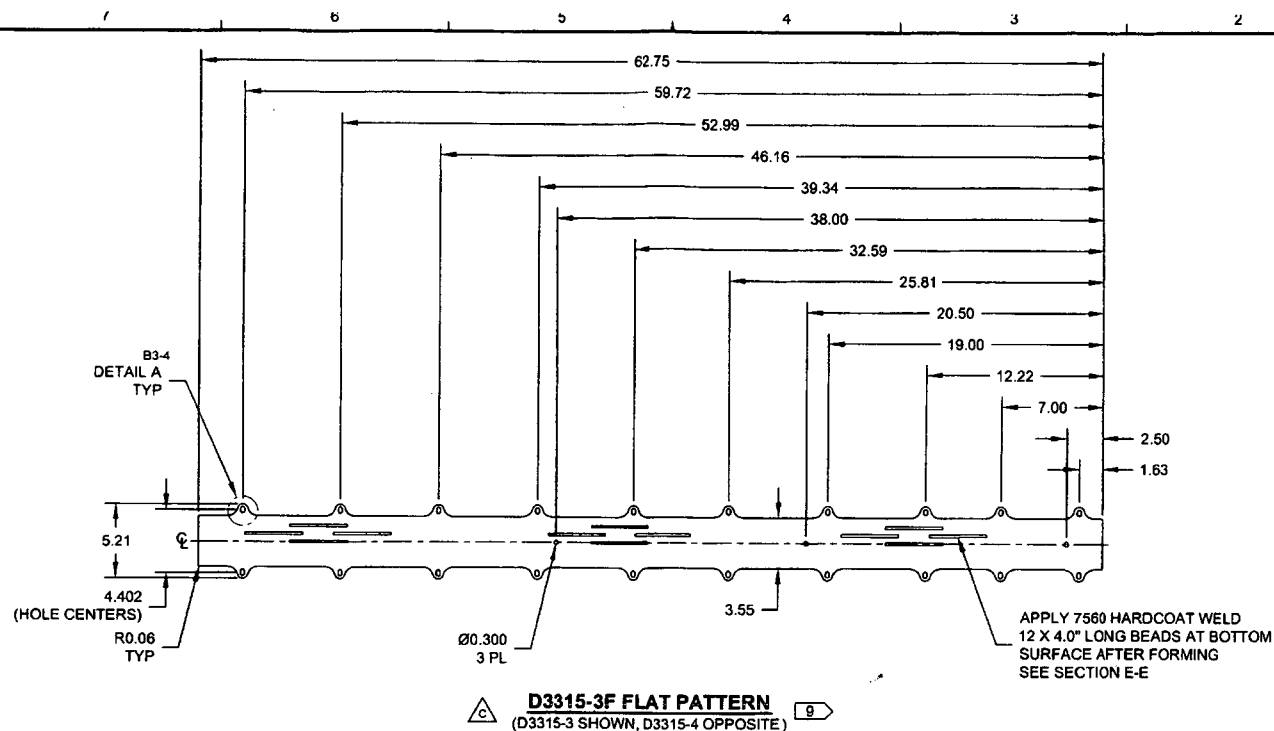


D3315-3/-4-3F NOTES:


- 1) MATERIAL: AISI 1010-1025 OR ASTM A36/A366/A1008 OR CSA G40-21, 38W/44W/50W/60W/70W SERIES STEEL, 16 GAUGE (0.060 THICK) REF. DART SPEC. M1010GA16
- 2) FINISH: POWDER COAT "GREY SANDEXT" (4.3.5.6) PER DART QSI 005 4.3
- 3) TOLERANCES: PER DART QSI 018 UNLESS OTHERWISE NOTED
- 4) UNITS: INCHES UNLESS OTHERWISE NOTED
- 5) BREAK SHARP EDGES: 0.005 TO 0.010 MAX
- 6) IDENTIFICATION: IDENTIFY WITH "TCCA-PDA, DART AEROSPACE LTD., P/N D3315-X B/N BXXXXX, FOR PRODUCT ELIGIBILITY SEE PDA05-17" PER DART QSI 044 6.5 (LABEL)
- 7) WEIGHT: 4.15 lbs
- 8) WELDING: PER DART QSI 004
- 9) WATERJET PROGRAMMING: PER D3315-3F_REV.C.DXF

| | | | |
|--|----------|--|--------------|
| DESIGN | PH | DART AEROSPACE LTD | |
| DRAWN | PH | HAWKESBURY, ONTARIO, CANADA | |
| CHECKED | CP | DRAWING NO. | REV. C |
| MFG. APPR. | MM | D3315 | SHEET 2 OF 4 |
| APPROVED | MM | TITLE | SCALE |
| DE APPR. | MM | WEARPLATE | NTS |
| DATE | 13.01.22 | COPYRIGHT © 2004 BY DART AEROSPACE LTD | |
| THIS DOCUMENT IS PRIVATE AND CONFIDENTIAL AND IS SUPPLIED ON THE EXPRESS CONDITION THAT IT IS NOT TO BE USED FOR ANY PURPOSE OR COPIED OR REPRODUCED IN ANY MANNER WITHOUT WRITTEN PERMISSION FROM DART AEROSPACE LTD. | | | |


RELEASED
2013-02-14

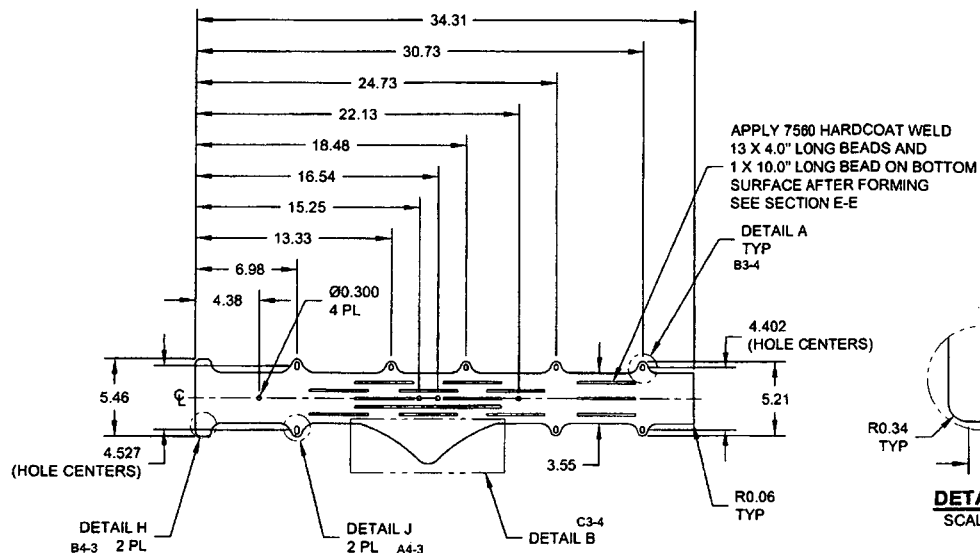


D3315-5F FLAT PATTERN
(D3315-5 SHOWN, D3315-6 OPPOSITE)

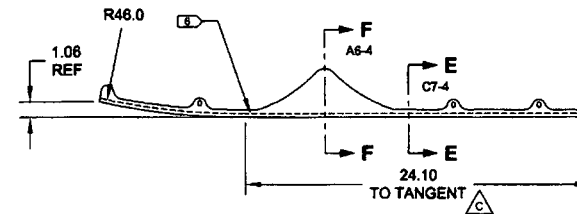


D3315-5 WEARPLATE
MAKE FROM D3315-5F

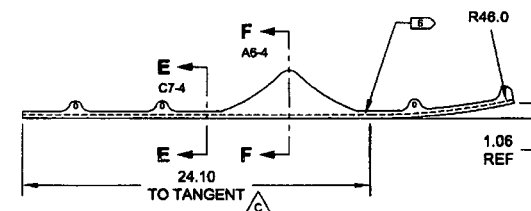

D3315-6 WEARPLATE
MAKE FROM D3315-5F

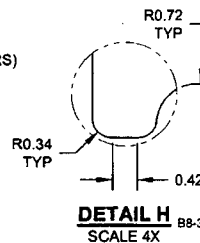

DETAIL H
SCALE 4X B8-3

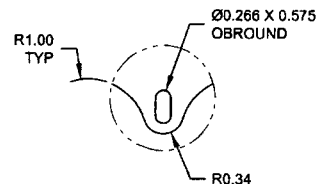

DETAIL J
SCALE 4X B8-3


D3315-5/-6/-5F NOTES:

- 1) MATERIAL: AISI 1010-1025 OR ASTM A36/A366/A1008 OR CSA G40-21, 38W/44W/50W/60W/70W SERIES STEEL, 16 GAUGE (0.060 THICK) REF. DART SPEC. M1010GA16
- 2) FINISH: POWDER COAT "GREY SANDTEX" (4.3.5.6) PER DART QSI 005 4.3
- 3) TOLERANCES: PER DART QSI 018 UNLESS OTHERWISE NOTED
- 4) UNITS: INCHES UNLESS OTHERWISE NOTED
- 5) BREAK SHARP EDGES: 0.005 TO 0.010 MAX
- 6) IDENTIFICATION: IDENTIFY WITH "TCCA-PDA, DART AEROSPACE LTD., P/N D3315-X B/N BXXXXX, FOR PRODUCT ELIGIBILITY SEE PDA05-17" PER DART QSI 044 6.5 (LABEL)
- 7) WEIGHT: 2.15 lbs
- 8) WELDING: PER DART QSI 004
- 9) WATERJET PROGRAMMING: PER D3315-5F_REV.C.DXF

RELEASED
2013-02-14


| | | | |
|------------|----------|--|--------------|
| DESIGN | PM | DART AEROSPACE LTD | |
| DRAWN | UP | HAWKESBURY, ONTARIO, CANADA | |
| CHECKED | UP | DRAWING NO. | REV. C |
| MFG. APPR. | UP | D3315 | SHEET 3 OF 4 |
| APPROVED | UP | TITLE | SCALE |
| DE APPR. | UP | WEARPLATE | NTS |
| DATE | 13.01.22 | COPYRIGHT © 2004 BY DART AEROSPACE LTD THIS DOCUMENT IS PRIVATE AND CONFIDENTIAL AND IS SUPPLIED ON THE EXPRESS CONDITION THAT IT IS NOT TO BE USED FOR ANY PURPOSE OR COPIED OR COMMUNICATED TO ANY OTHER PERSON WITHOUT WRITTEN PERMISSION FROM DART AEROSPACE LTD. | |

8 7 6 5 4 3 2 1

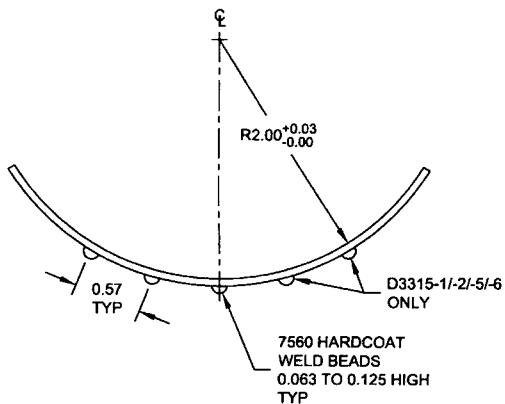


DETAIL E
SCALE 8X

B2-1
D3-1
B6-2
B2-3
D1-3

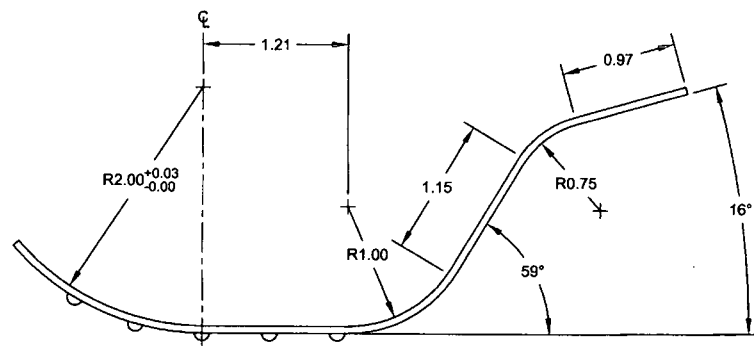


DETAIL F
SCALE 8X

C2-1
D2-1
C2-3
D2-3

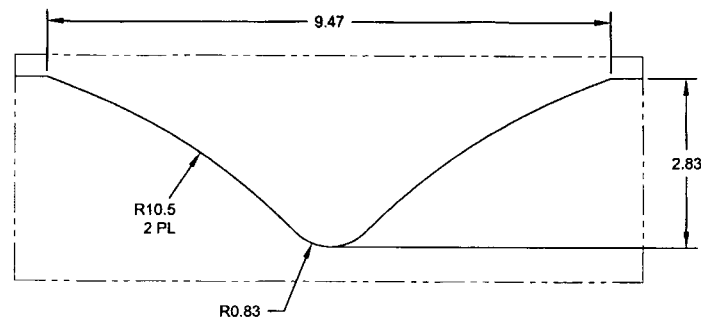


DETAIL B B6-1
SCALE 4X B6-3

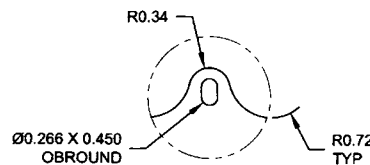

DETAIL A
SCALE 4X

C8-1
C7-2
C5-3

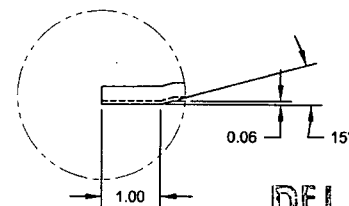

DETAIL D: JOGGLE
SCALE 4X

D3-1
B7-2

RELEASED
2013-02-1

| | | | |
|------------|----------|--|--------------|
| DESIGN | | DART AEROSPACE LTD | |
| DRAWN | | HAWKESBURY, ONTARIO, CANADA | |
| CHECKED | | DRAWING NO. | REV. C |
| MFG. APPR. | | D3315 | SHEET 4 OF 4 |
| APPROVED | | TITLE | SCALE |
| DE APPR. | | WEARPLATE | NTS |
| DATE | 13.01.22 | <small>COPYRIGHT © 2004 BY DART AEROSPACE LTD THIS DOCUMENT IS PRIVATE AND CONFIDENTIAL AND IS SUPPLIED ON THE EXPRESS CONDITION THAT IT IS NOT TO BE USED FOR ANY PURPOSE OR COMPILED OR COMMUNICATED TO ANY OTHER PERSON WITHOUT WRITTEN PERMISSION FROM DART AEROSPACE LTD.</small> | |

8 7 6 5 4 3 2 1